
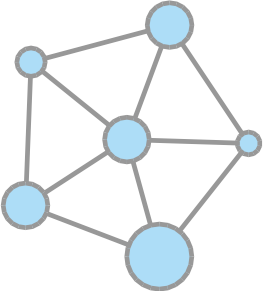


BATFER INVESTMENT S.A. RESERVES THE OWNERSHIP OF THIS DOCUMENT. IT IS PROHIBITED TO REPRODUCE, MODIFY OR TRANSFER WITHOUT PRIOR WRITTEN AUTHORIZATION.

NOTE: cables not indicated will be black 0.75mm²/18 AWG

1	2	3	4	5	6	7	8																																																											
A								A																																																										
B	 BATFER Investment S.A.							B																																																										
C								C																																																										
D	Client: MMA Project: CONT. HD ELECTRONICO NA mSafe 220V SHELL Description Document: P&ID + Functional Diagrams Document Number: 75206 ZPL Revision: 2					APROBADO PARA PRODUCCION APROBADO: MPV FECHA: 07/10/2025 BATFER Investment S.A.		D																																																										
E	Installation Place -							E																																																										
F	<table><tr><td>-</td><td>-</td><td>-</td><td>-</td><td>-</td><td>-</td><td>PROJECT: CONT. HD ELECTRONICO NA mSafe 220V</td><td rowspan="5">  BATFER Investment S.A. </td><td colspan="2">DOC NUMBER: 75206 ZPL</td><td colspan="2">GRAL REV: 2</td><td>F</td></tr><tr><td>2</td><td>Connector removed from board</td><td>07/10/25</td><td>MMR</td><td>MMR</td><td>MPV</td><td>CODE: 75206-1</td><td colspan="2">TITLE: Functional Diagram-mSafe NA 220V</td><td></td><td>REV:</td><td></td></tr><tr><td>1</td><td>Chg Reg,24V P-Tx int/ext,RC Com</td><td>21/07/25</td><td>MPV</td><td>MMR</td><td>MPV</td><td>CLIENT: MMA</td><td colspan="2">P&ID + Functional</td><td>00</td><td>2</td></tr><tr><td>0</td><td>AS BUILT (In Factory)</td><td>21/03/25</td><td>MPV</td><td>NBG</td><td>MPV</td><td></td><td colspan="2">-</td><td></td><td></td></tr><tr><td>REV</td><td>DESCRIPTION</td><td>DATE</td><td>PROJ.</td><td>DW.</td><td>APR.</td><td></td><td colspan="2"></td><td>CONT:</td><td>01</td></tr></table>							-	-	-	-	-	-	PROJECT: CONT. HD ELECTRONICO NA mSafe 220V	 BATFER Investment S.A.	DOC NUMBER: 75206 ZPL		GRAL REV: 2		F	2	Connector removed from board	07/10/25	MMR	MMR	MPV	CODE: 75206-1	TITLE: Functional Diagram-mSafe NA 220V			REV:		1	Chg Reg,24V P-Tx int/ext,RC Com	21/07/25	MPV	MMR	MPV	CLIENT: MMA	P&ID + Functional		00	2	0	AS BUILT (In Factory)	21/03/25	MPV	NBG	MPV		-				REV	DESCRIPTION	DATE	PROJ.	DW.	APR.				CONT:	01	F
-	-	-	-	-	-	PROJECT: CONT. HD ELECTRONICO NA mSafe 220V	 BATFER Investment S.A.	DOC NUMBER: 75206 ZPL		GRAL REV: 2		F																																																						
2	Connector removed from board	07/10/25	MMR	MMR	MPV	CODE: 75206-1		TITLE: Functional Diagram-mSafe NA 220V			REV:																																																							
1	Chg Reg,24V P-Tx int/ext,RC Com	21/07/25	MPV	MMR	MPV	CLIENT: MMA		P&ID + Functional		00	2																																																							
0	AS BUILT (In Factory)	21/03/25	MPV	NBG	MPV			-																																																										
REV	DESCRIPTION	DATE	PROJ.	DW.	APR.					CONT:	01																																																							

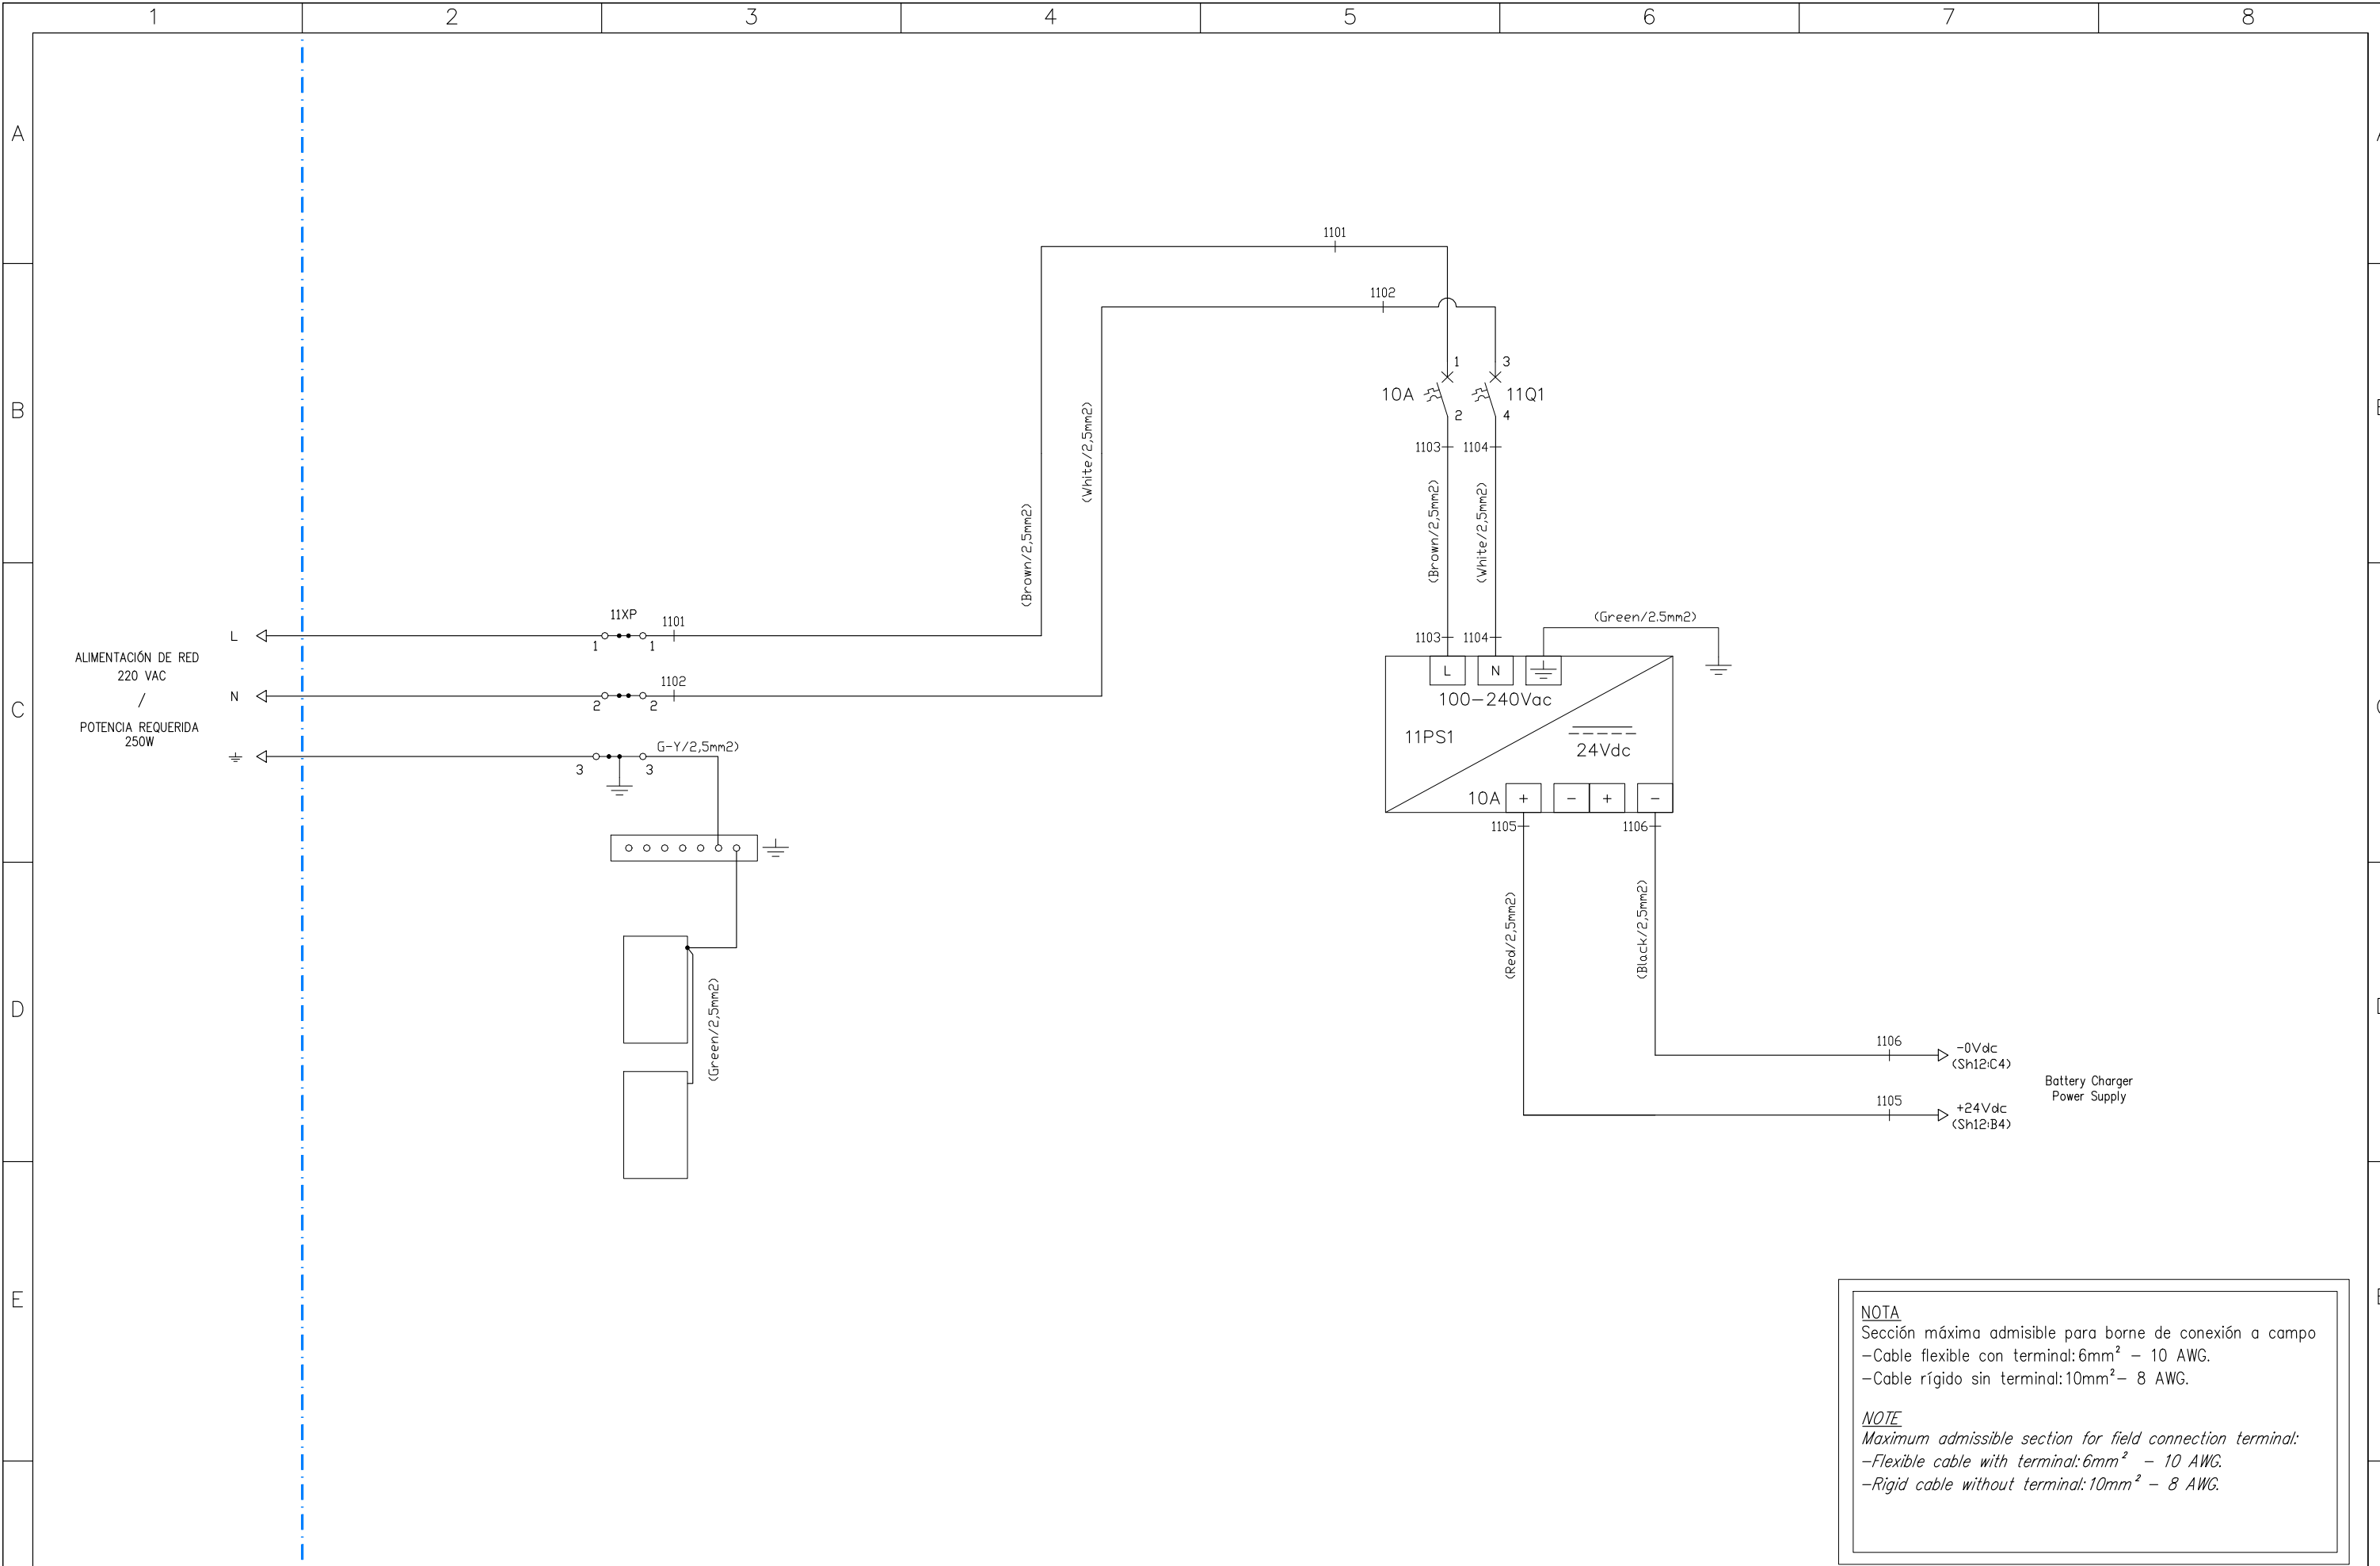


NOTA
Sección máxima admisible para borne de conexión a campo
-Cable flexible con terminal: 6mm² - 10 AWG.
-Cable rígido sin terminal: 10mm² - 8 AWG.

NOTE
Maximum admissible section for field connection terminal:
-Flexible cable with terminal: 6mm² - 10 AWG.
-Rigid cable without terminal: 10mm² - 8 AWG.

-	-	-	-	-	-
2	Connector removed from board	07/10/25	MMR	MMR	MPV
1	Chg Reg, 24V P-Tx int/ext, RC Com	21/07/25	MPV	MMR	MPV
0	AS BUILT (In Factory)	21/03/25	MPV	NBG	MPV
REV	DESCRIPTION	DATE	PROJ.	DW.	APR.


PROJECT: CONT. HD ELECTRONICO NA mSafe 220V
CODE: 75206-1
CLIENT: MMA

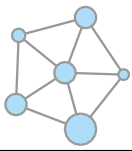

BATFER
Investment S.A.


DOC NUMBER: 75206 ZPL
TITLE: Functional Diagram-mSafe NA 220V Power Supply

GRAL REV: 2	
11	REV: 2
CONT: 12	

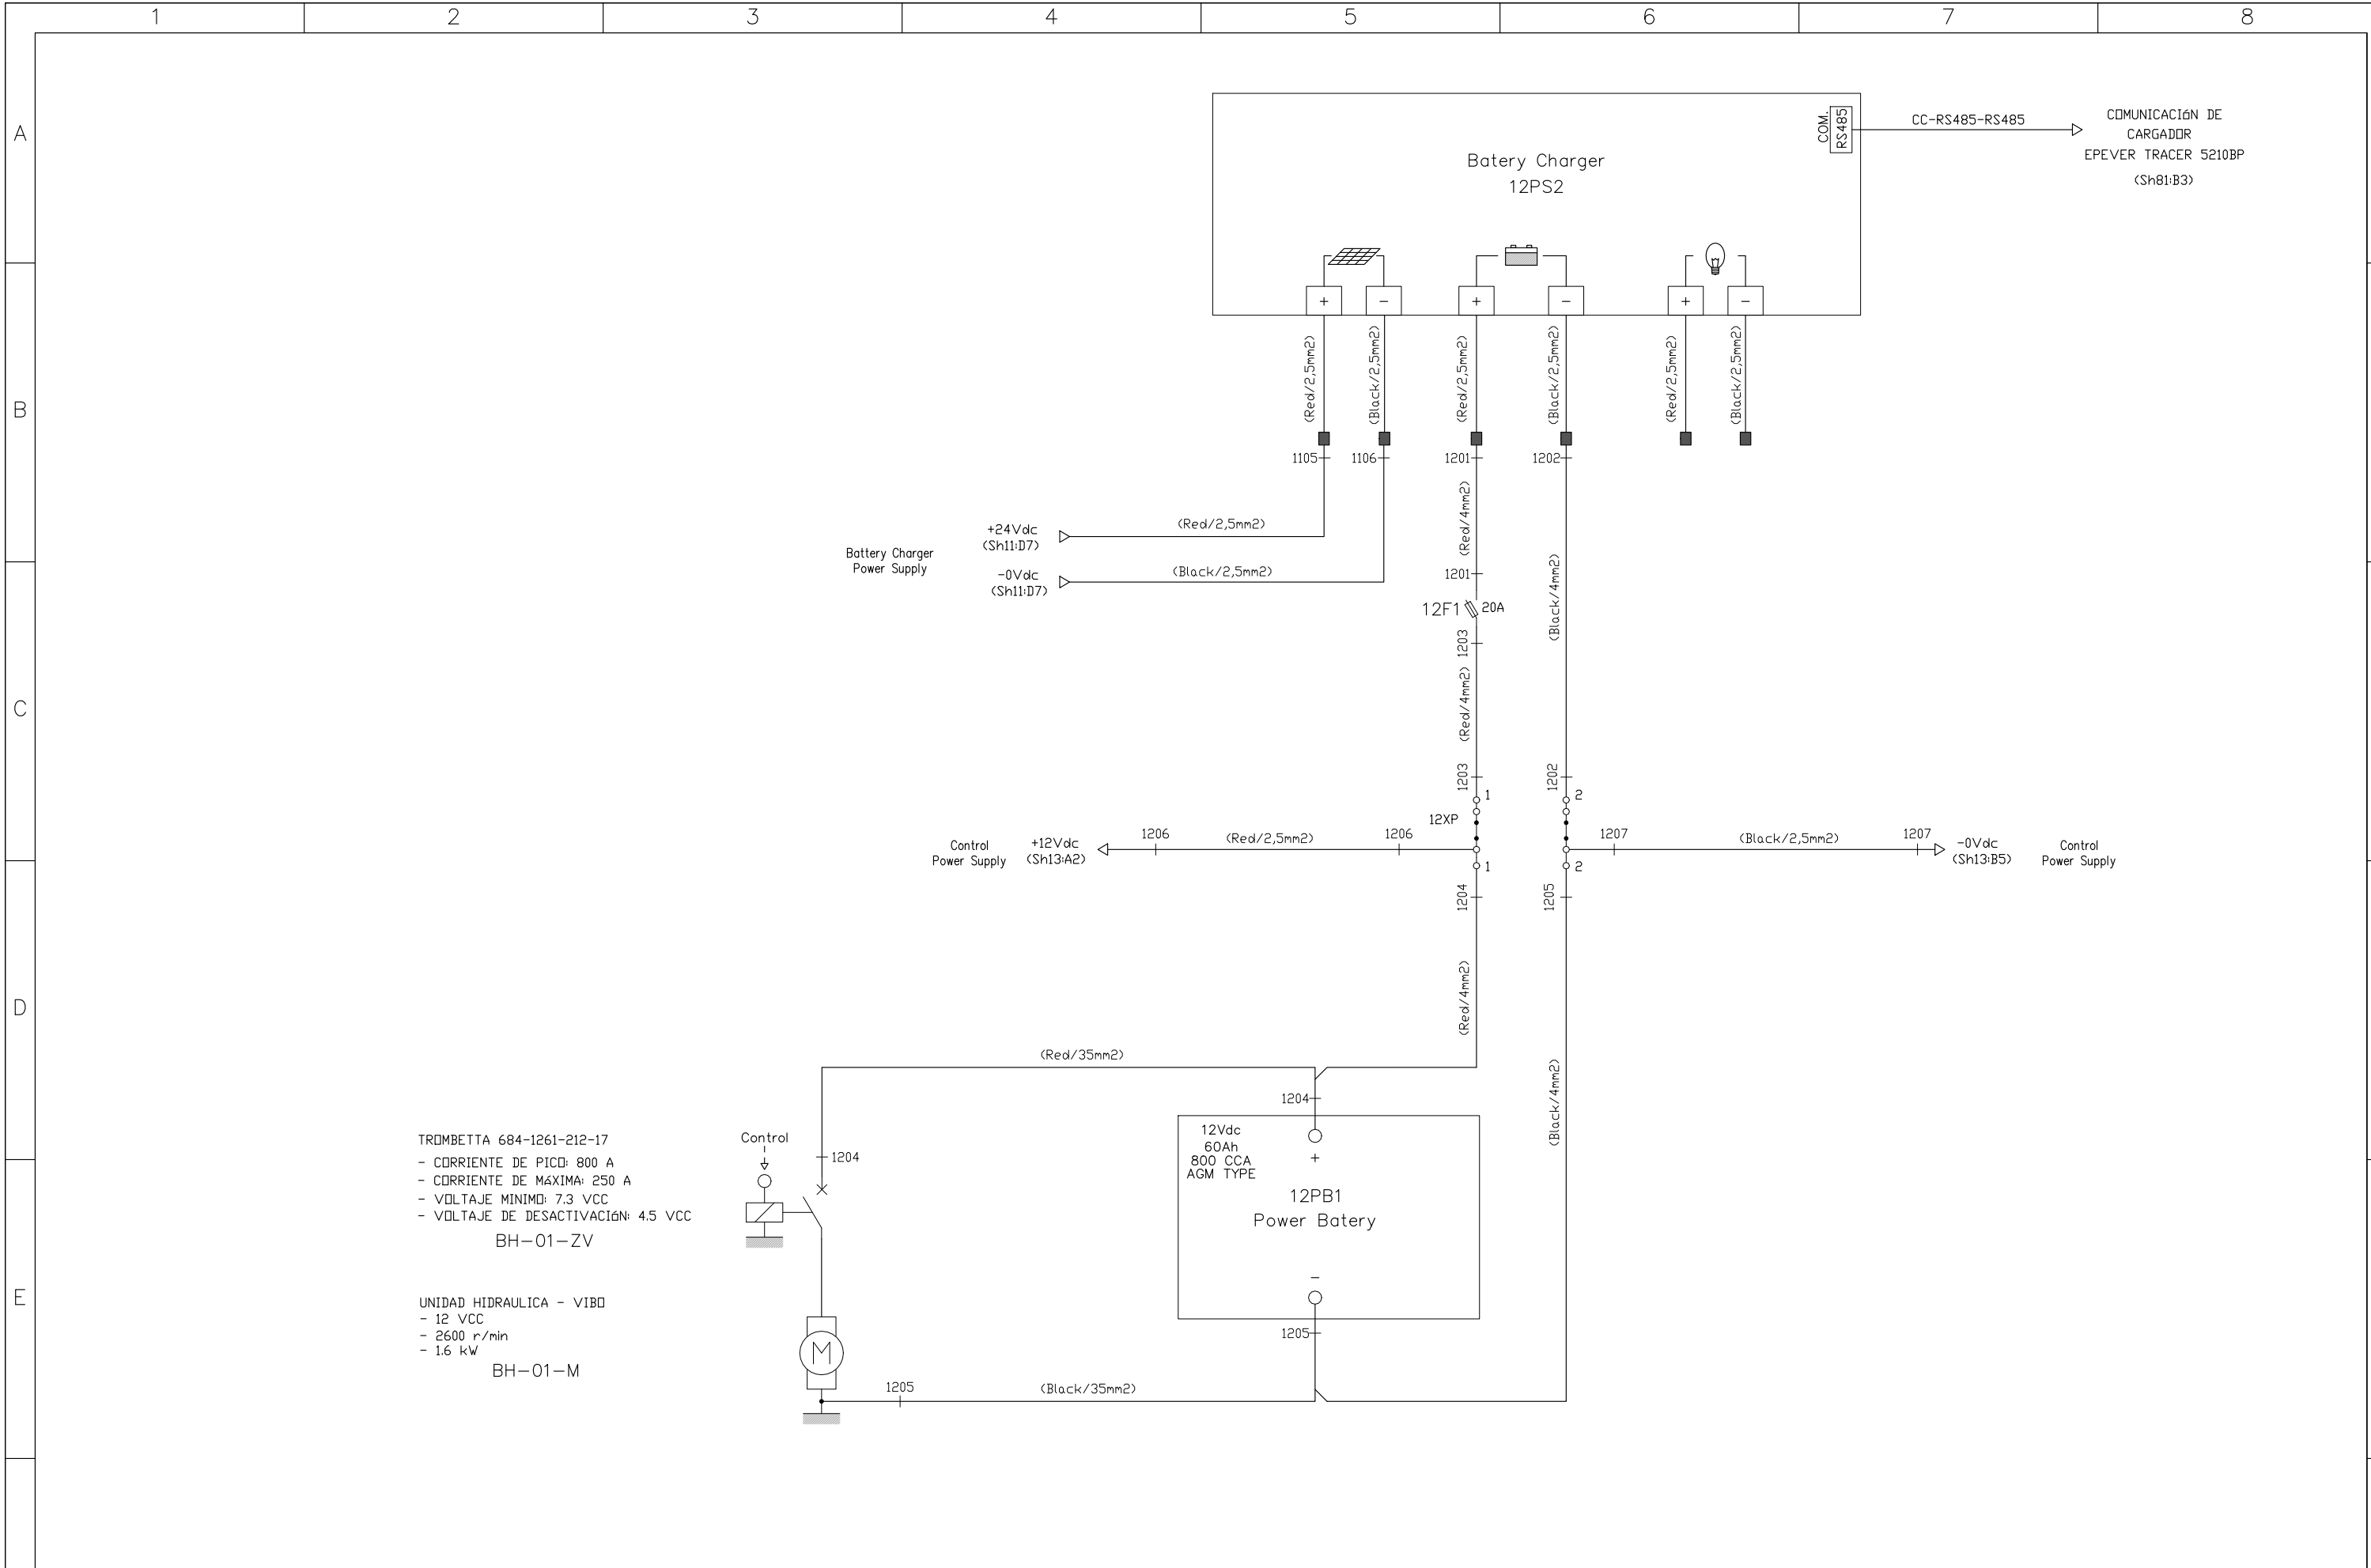

-	-	-	-	-	-
2	Connector removed from board	07/10/25	MMR	MMR	MPV
1	Chg Reg,24V P-Tx int/ext,RC Com	21/07/25	MPV	MMR	MPV
0	AS BUILT (In Factory)	21/03/25	MPV	NBG	MPV
REV	DESCRIPTION	DATE	PROJ.	DW.	APR.


PROJECT:	CONT. HD ELECTRONICO NA mSafe 220V
CODE:	75206-1
CLIENT:	MMA

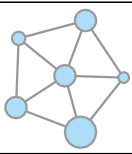


BATFER
Investment S.A.


DOC NUMBER:	75206 ZPL
TITLE:	Functional Diagram-mSafe NA 220V Battery Chargers and Power Circuits
-	-

GRAL REV:	2
REV:	2
CONT:	13

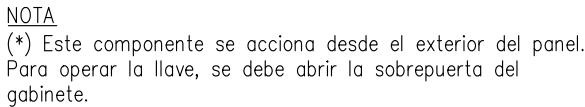


—	—	—	—	—	PROJECT: CONT. HD ELECTRONICO NA mSafe 220V		DOC NUMBER: 75206 ZPL	GRAL REV: 2		
2	Connector removed from board	07/10/25	MMR	MMR	MPV		CODE: 75206-1	TITLE: Functional Diagram-mSafe NA 220V Control Voltage Generation and Distribution	REV:	
1	Chg Reg,24V P-Tx int/ext,RC Com	21/07/25	MPV	MMR	MPV		CLIENT: MMA		13	2
0	AS BUILT (In Factory)	21/03/25	MPV	NBG	MPV				CONT:	14
REV	DESCRIPTION	DATE	PROJ.	DW.	APR.					

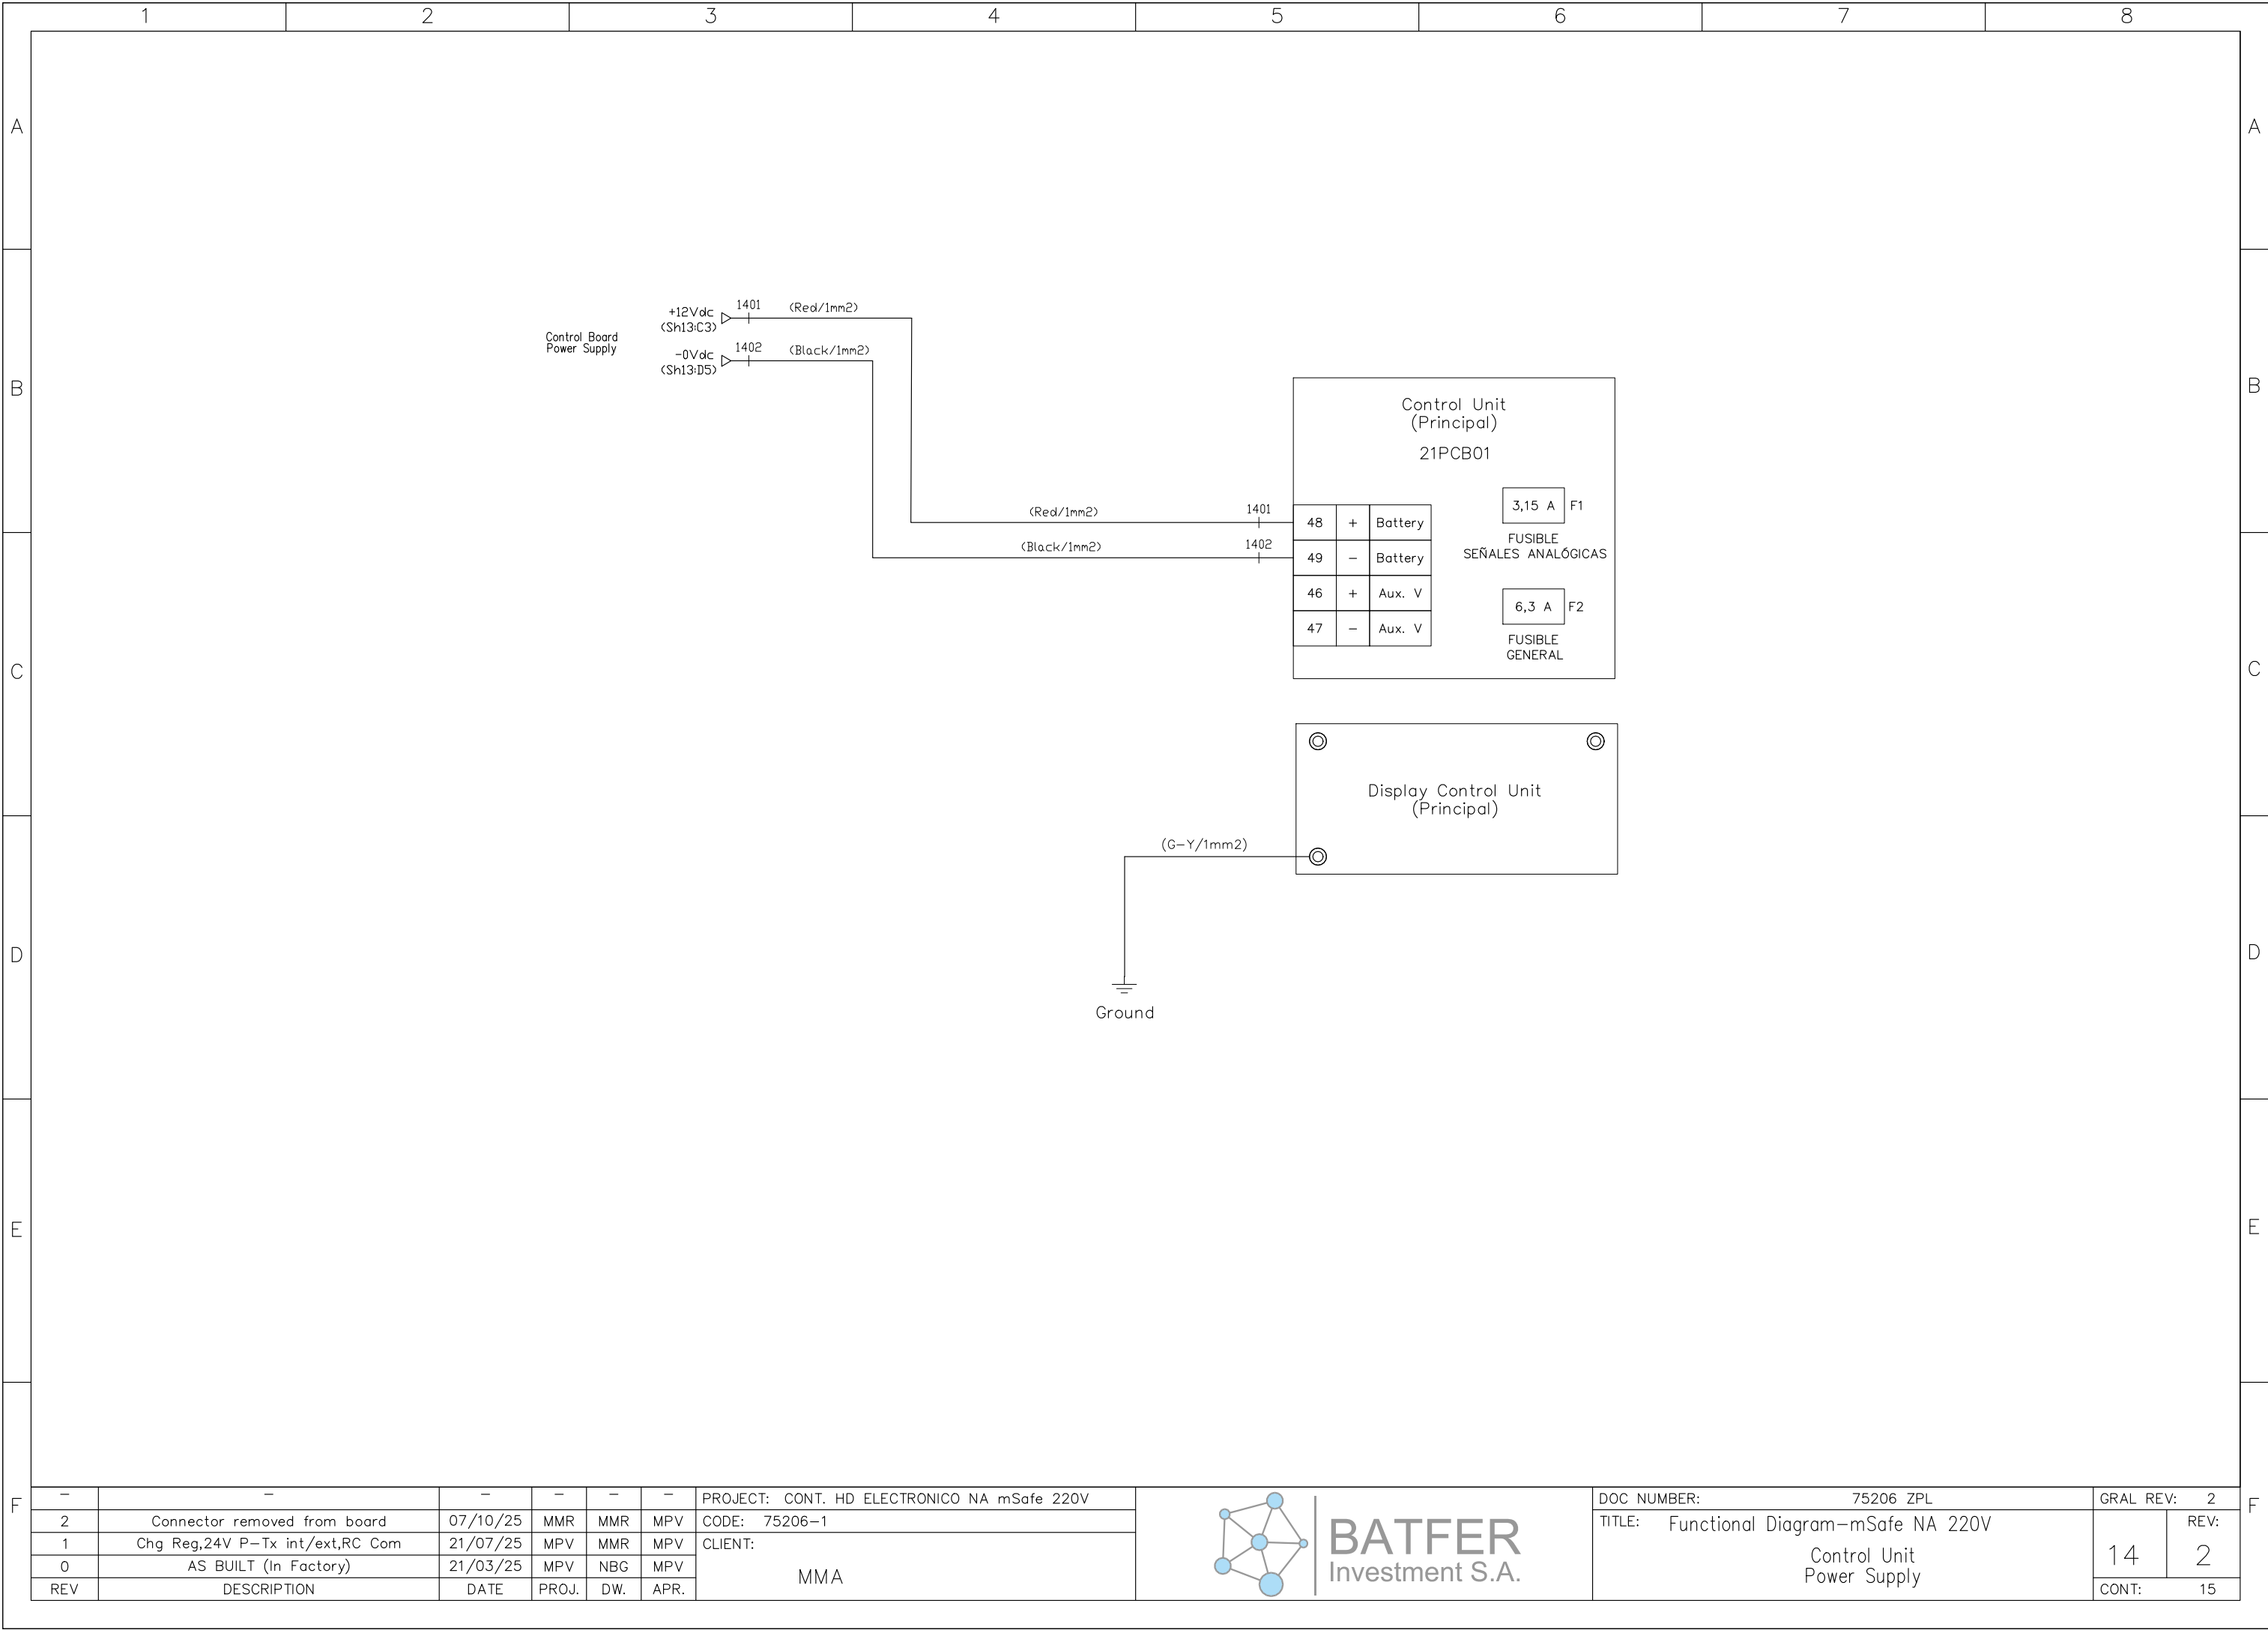

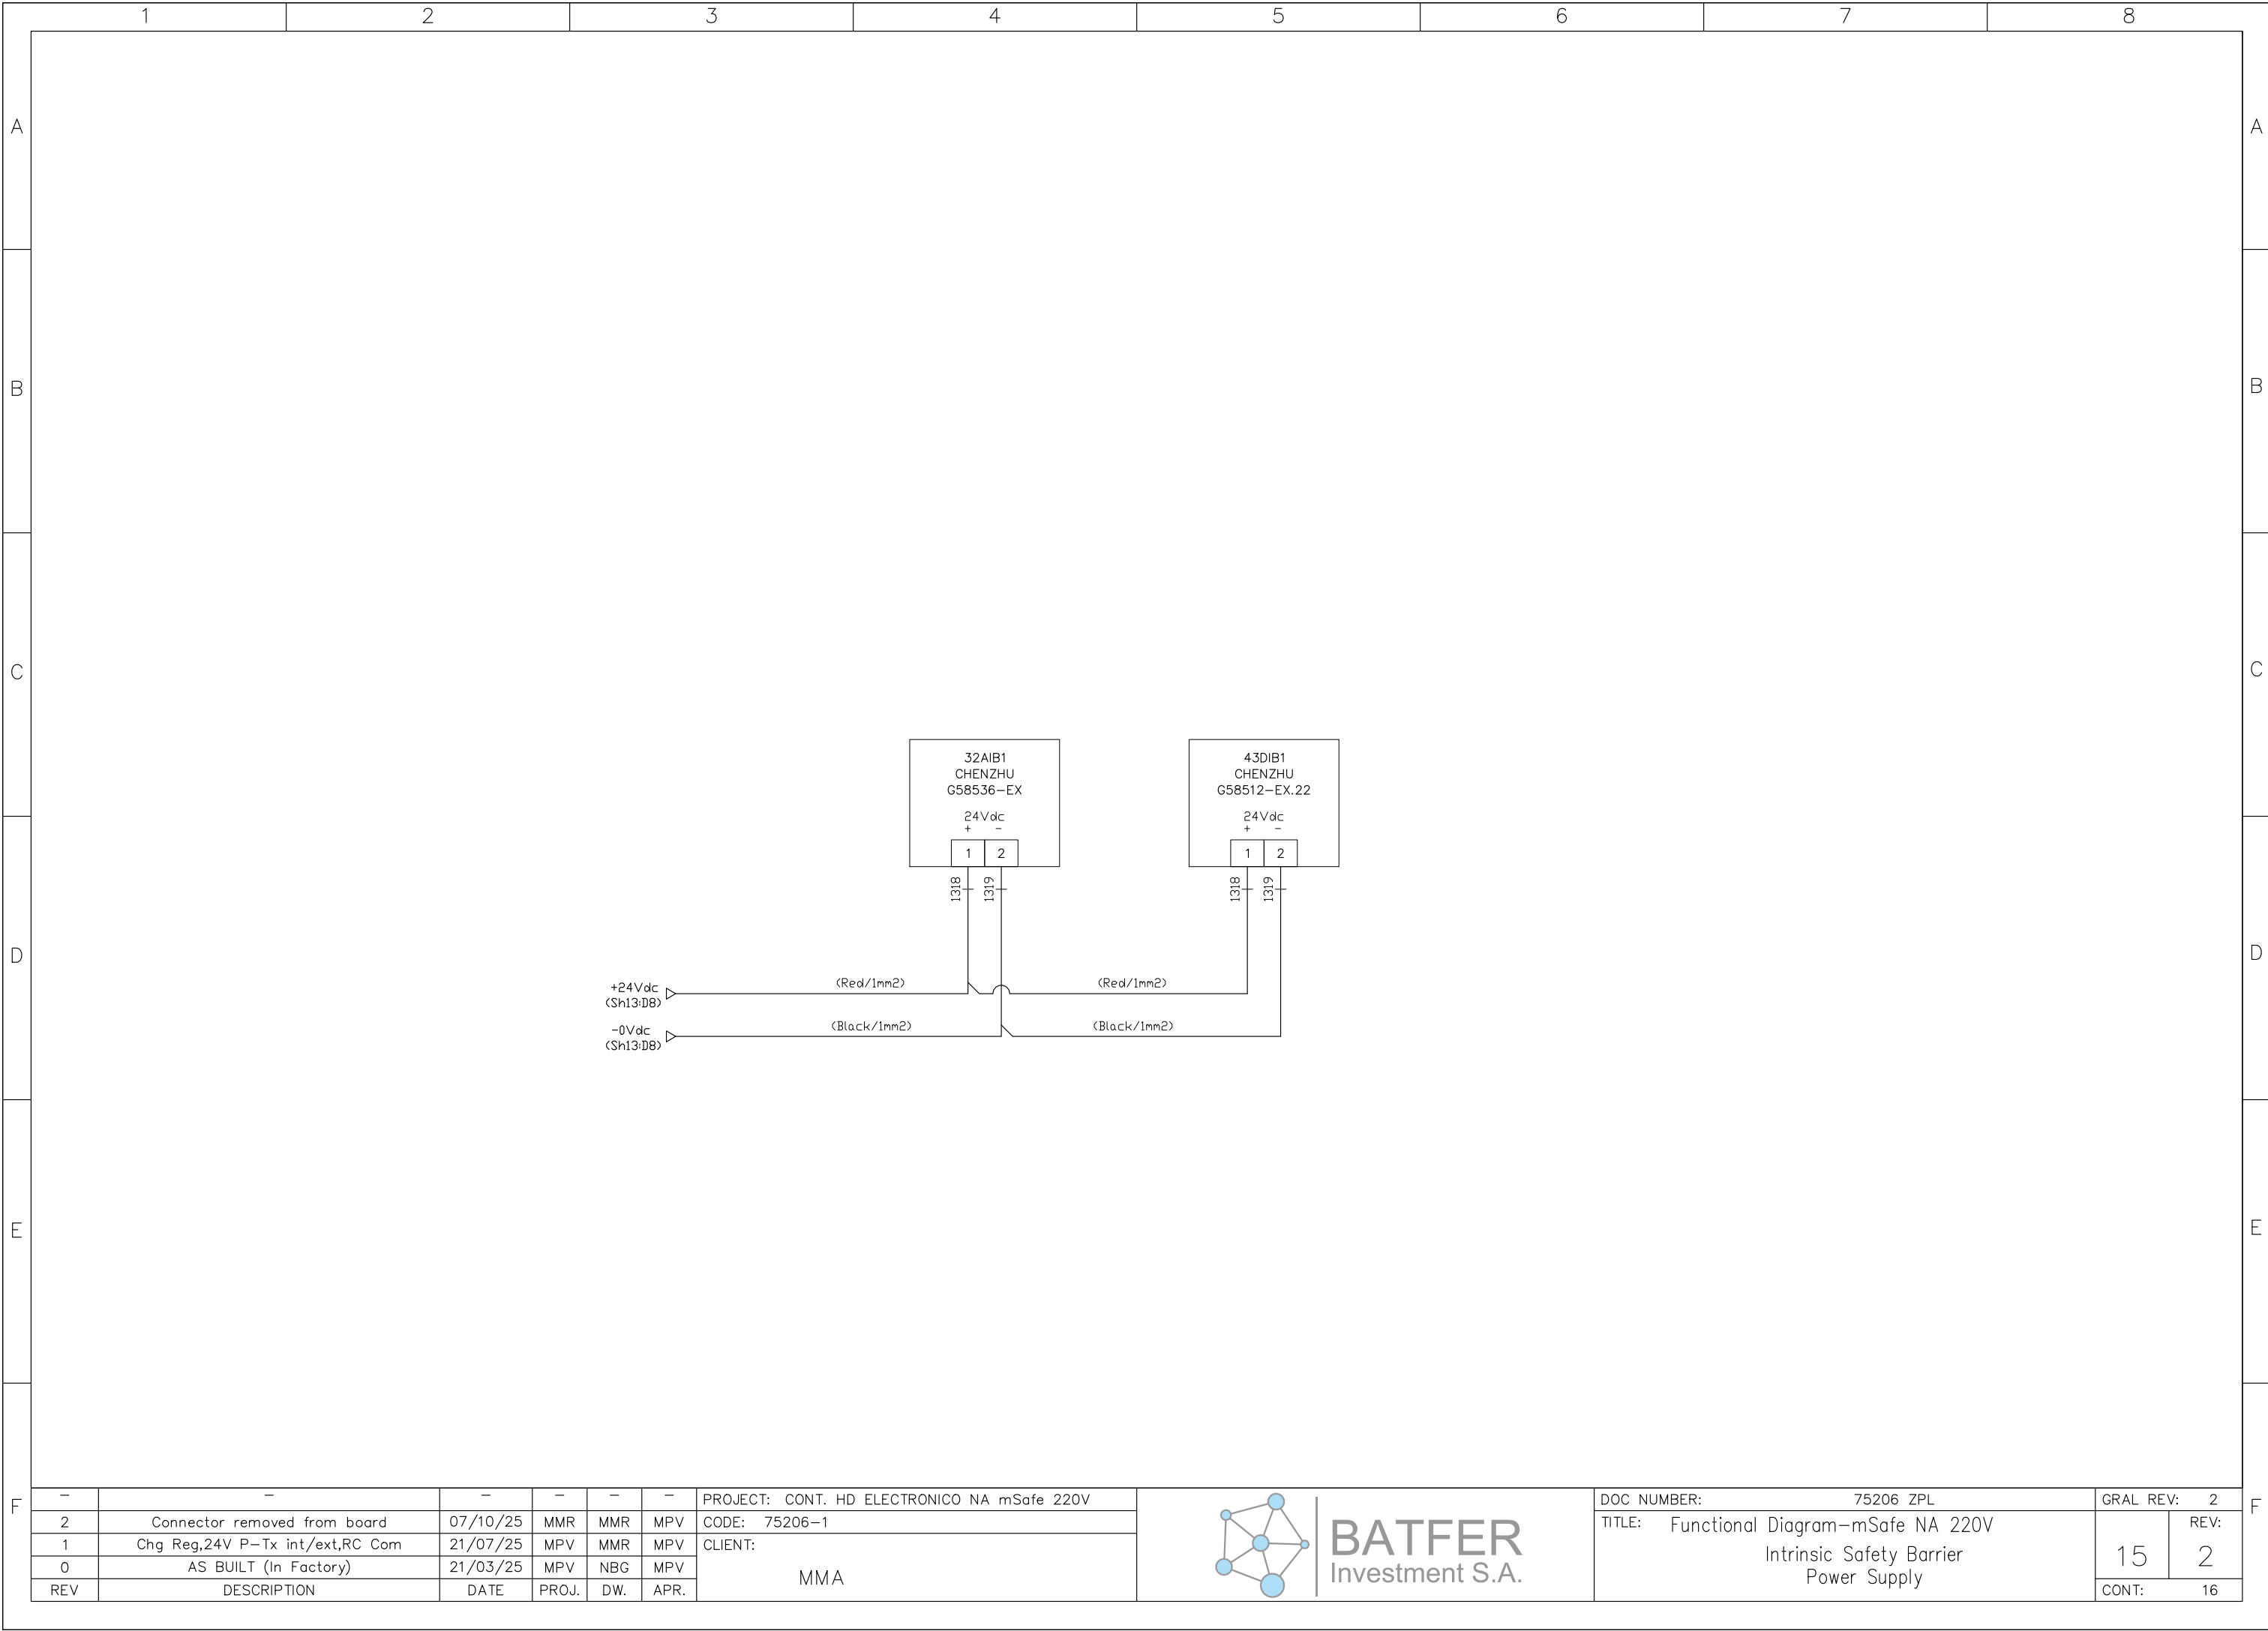


BATFER INVESTMENT S.A RESERVES THE OWNERSHIP OF THIS DOCUMENT. IT IS PROHIBITED TO REPRODUCE, MODIFY OR TRANSFER WITHOUT PRIOR WRITTEN AUTHORIZATION.

NOTE: cables not indicated will be black 0.75mm²/18 AWG

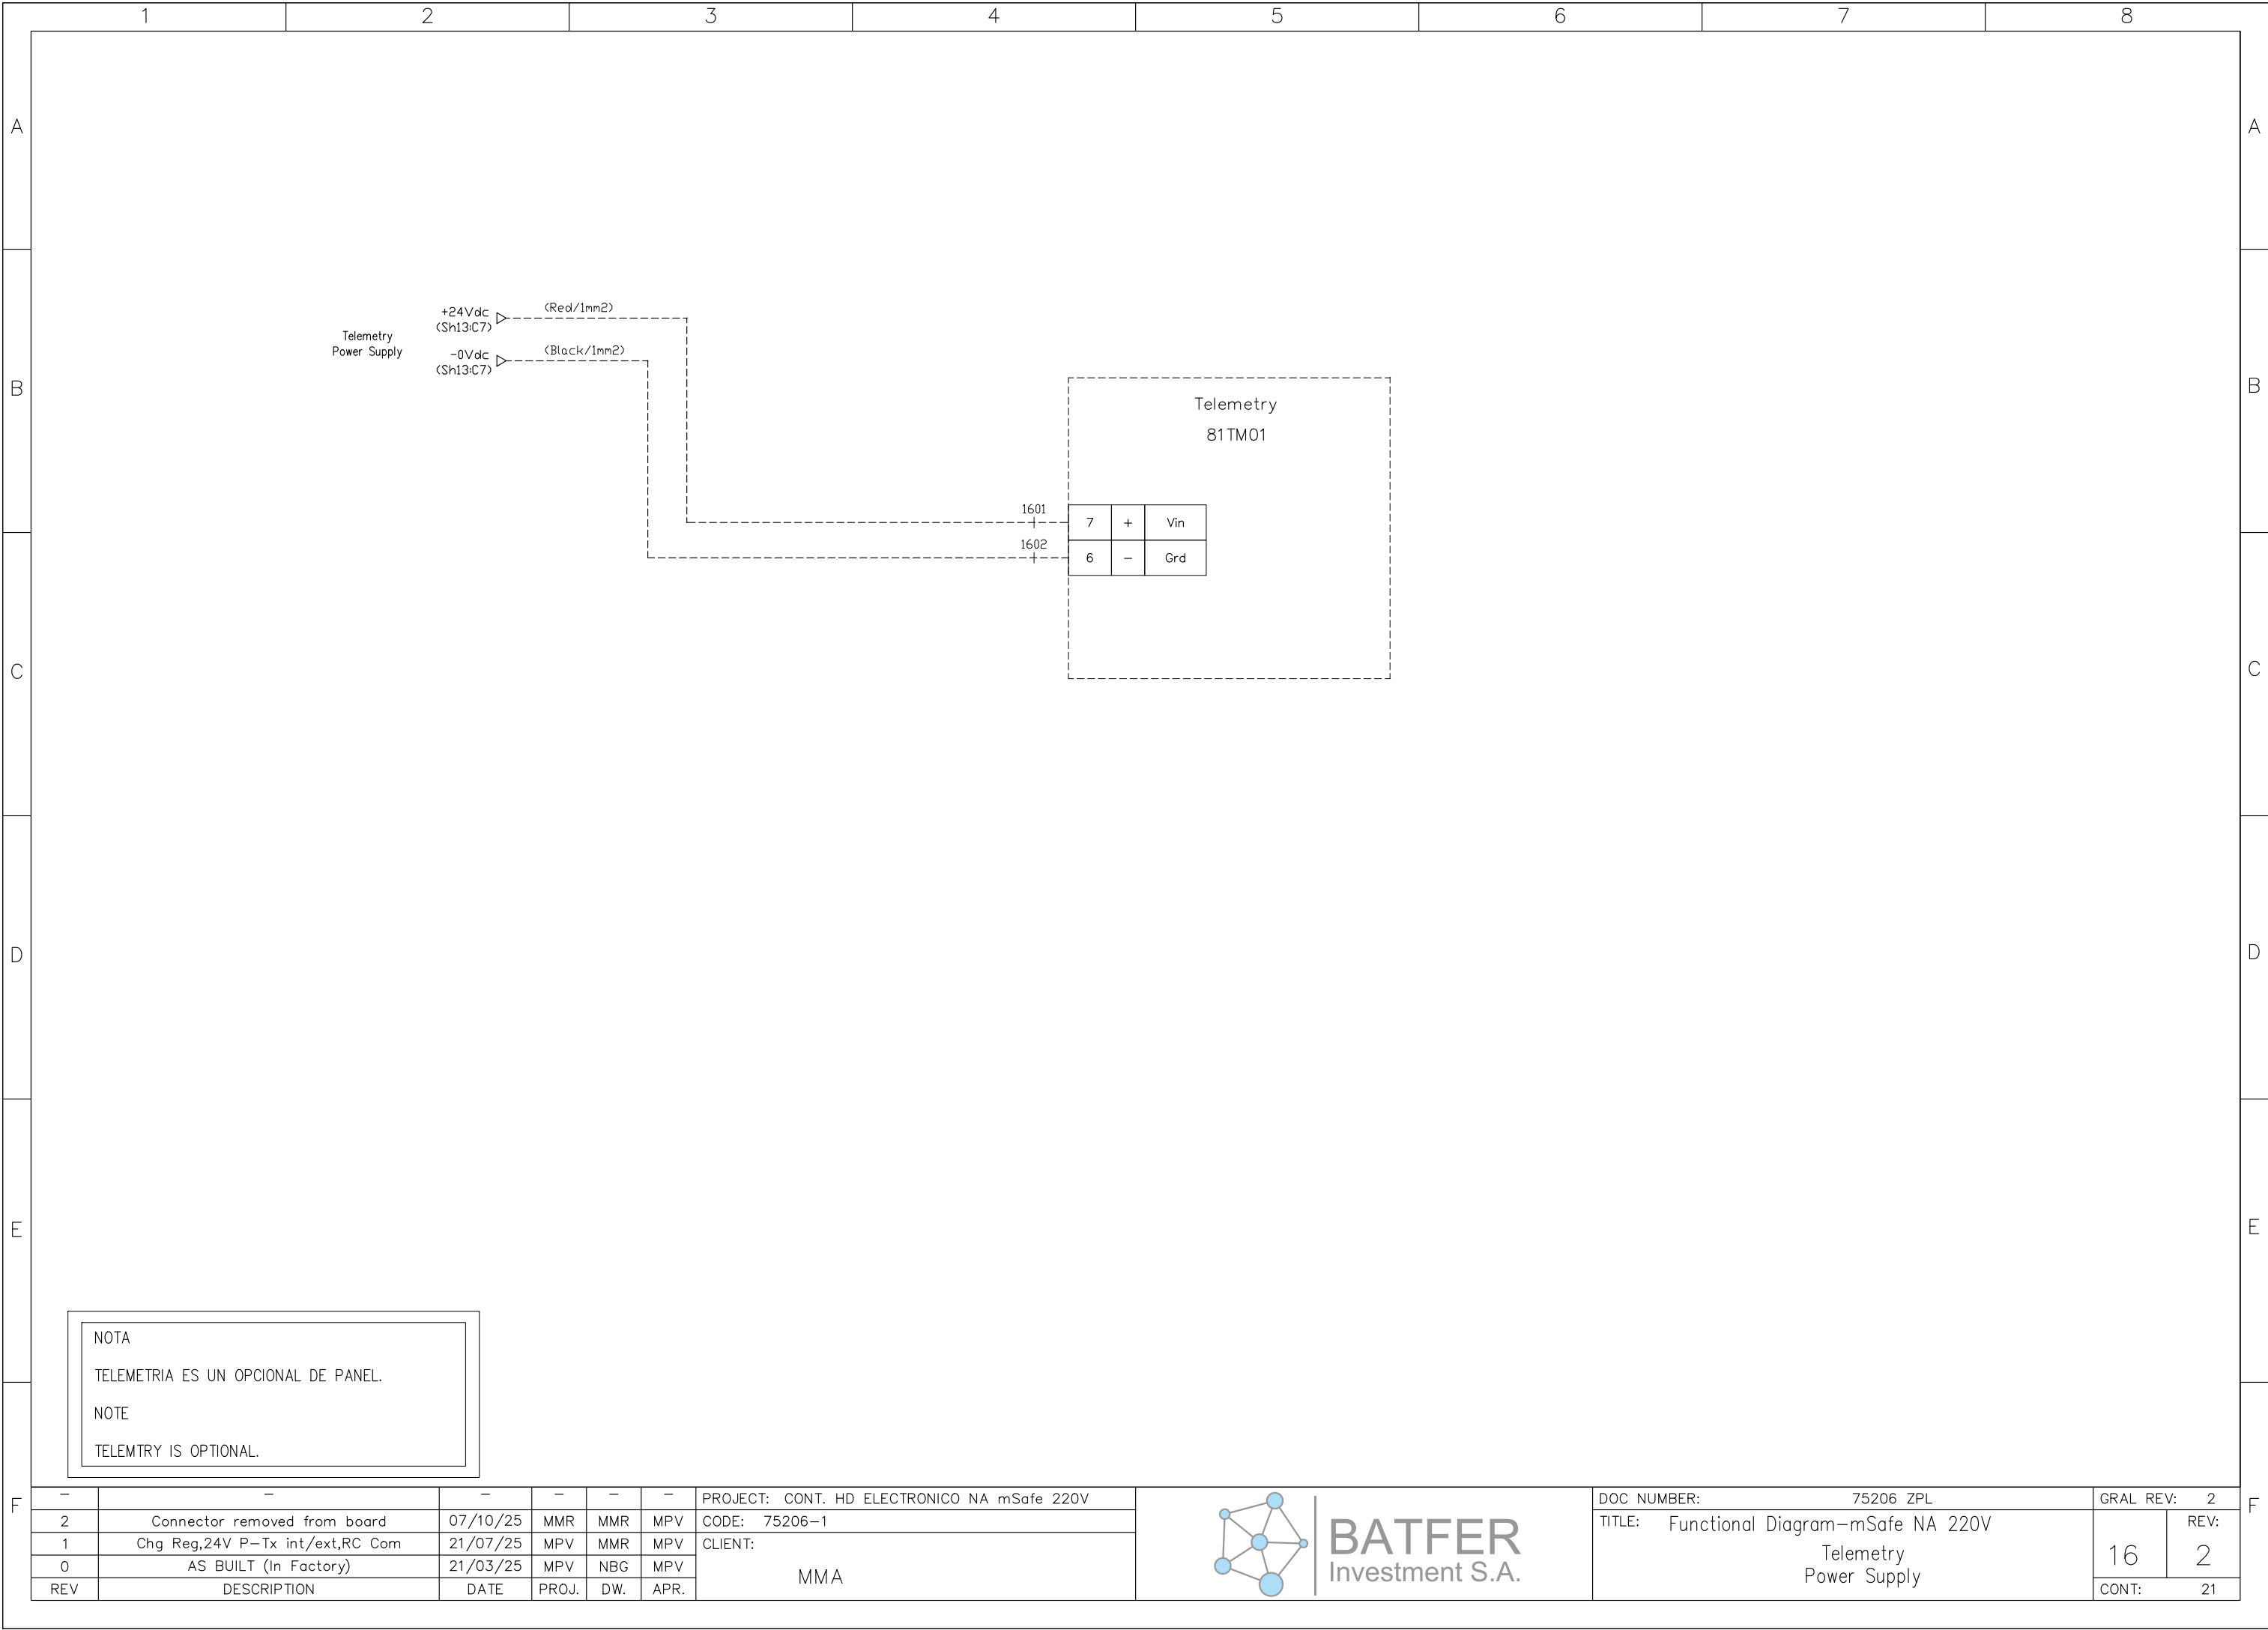


BATFER INVESTMENT S.A. RESERVES THE OWNERSHIP OF THIS DOCUMENT. IT IS PROHIBITED TO REPRODUCE, MODIFY OR TRANSFER WITHOUT PRIOR WRITTEN AUTHORIZATION.


NOTE: cables not indicated will be black 0.75mm²/18 AWG

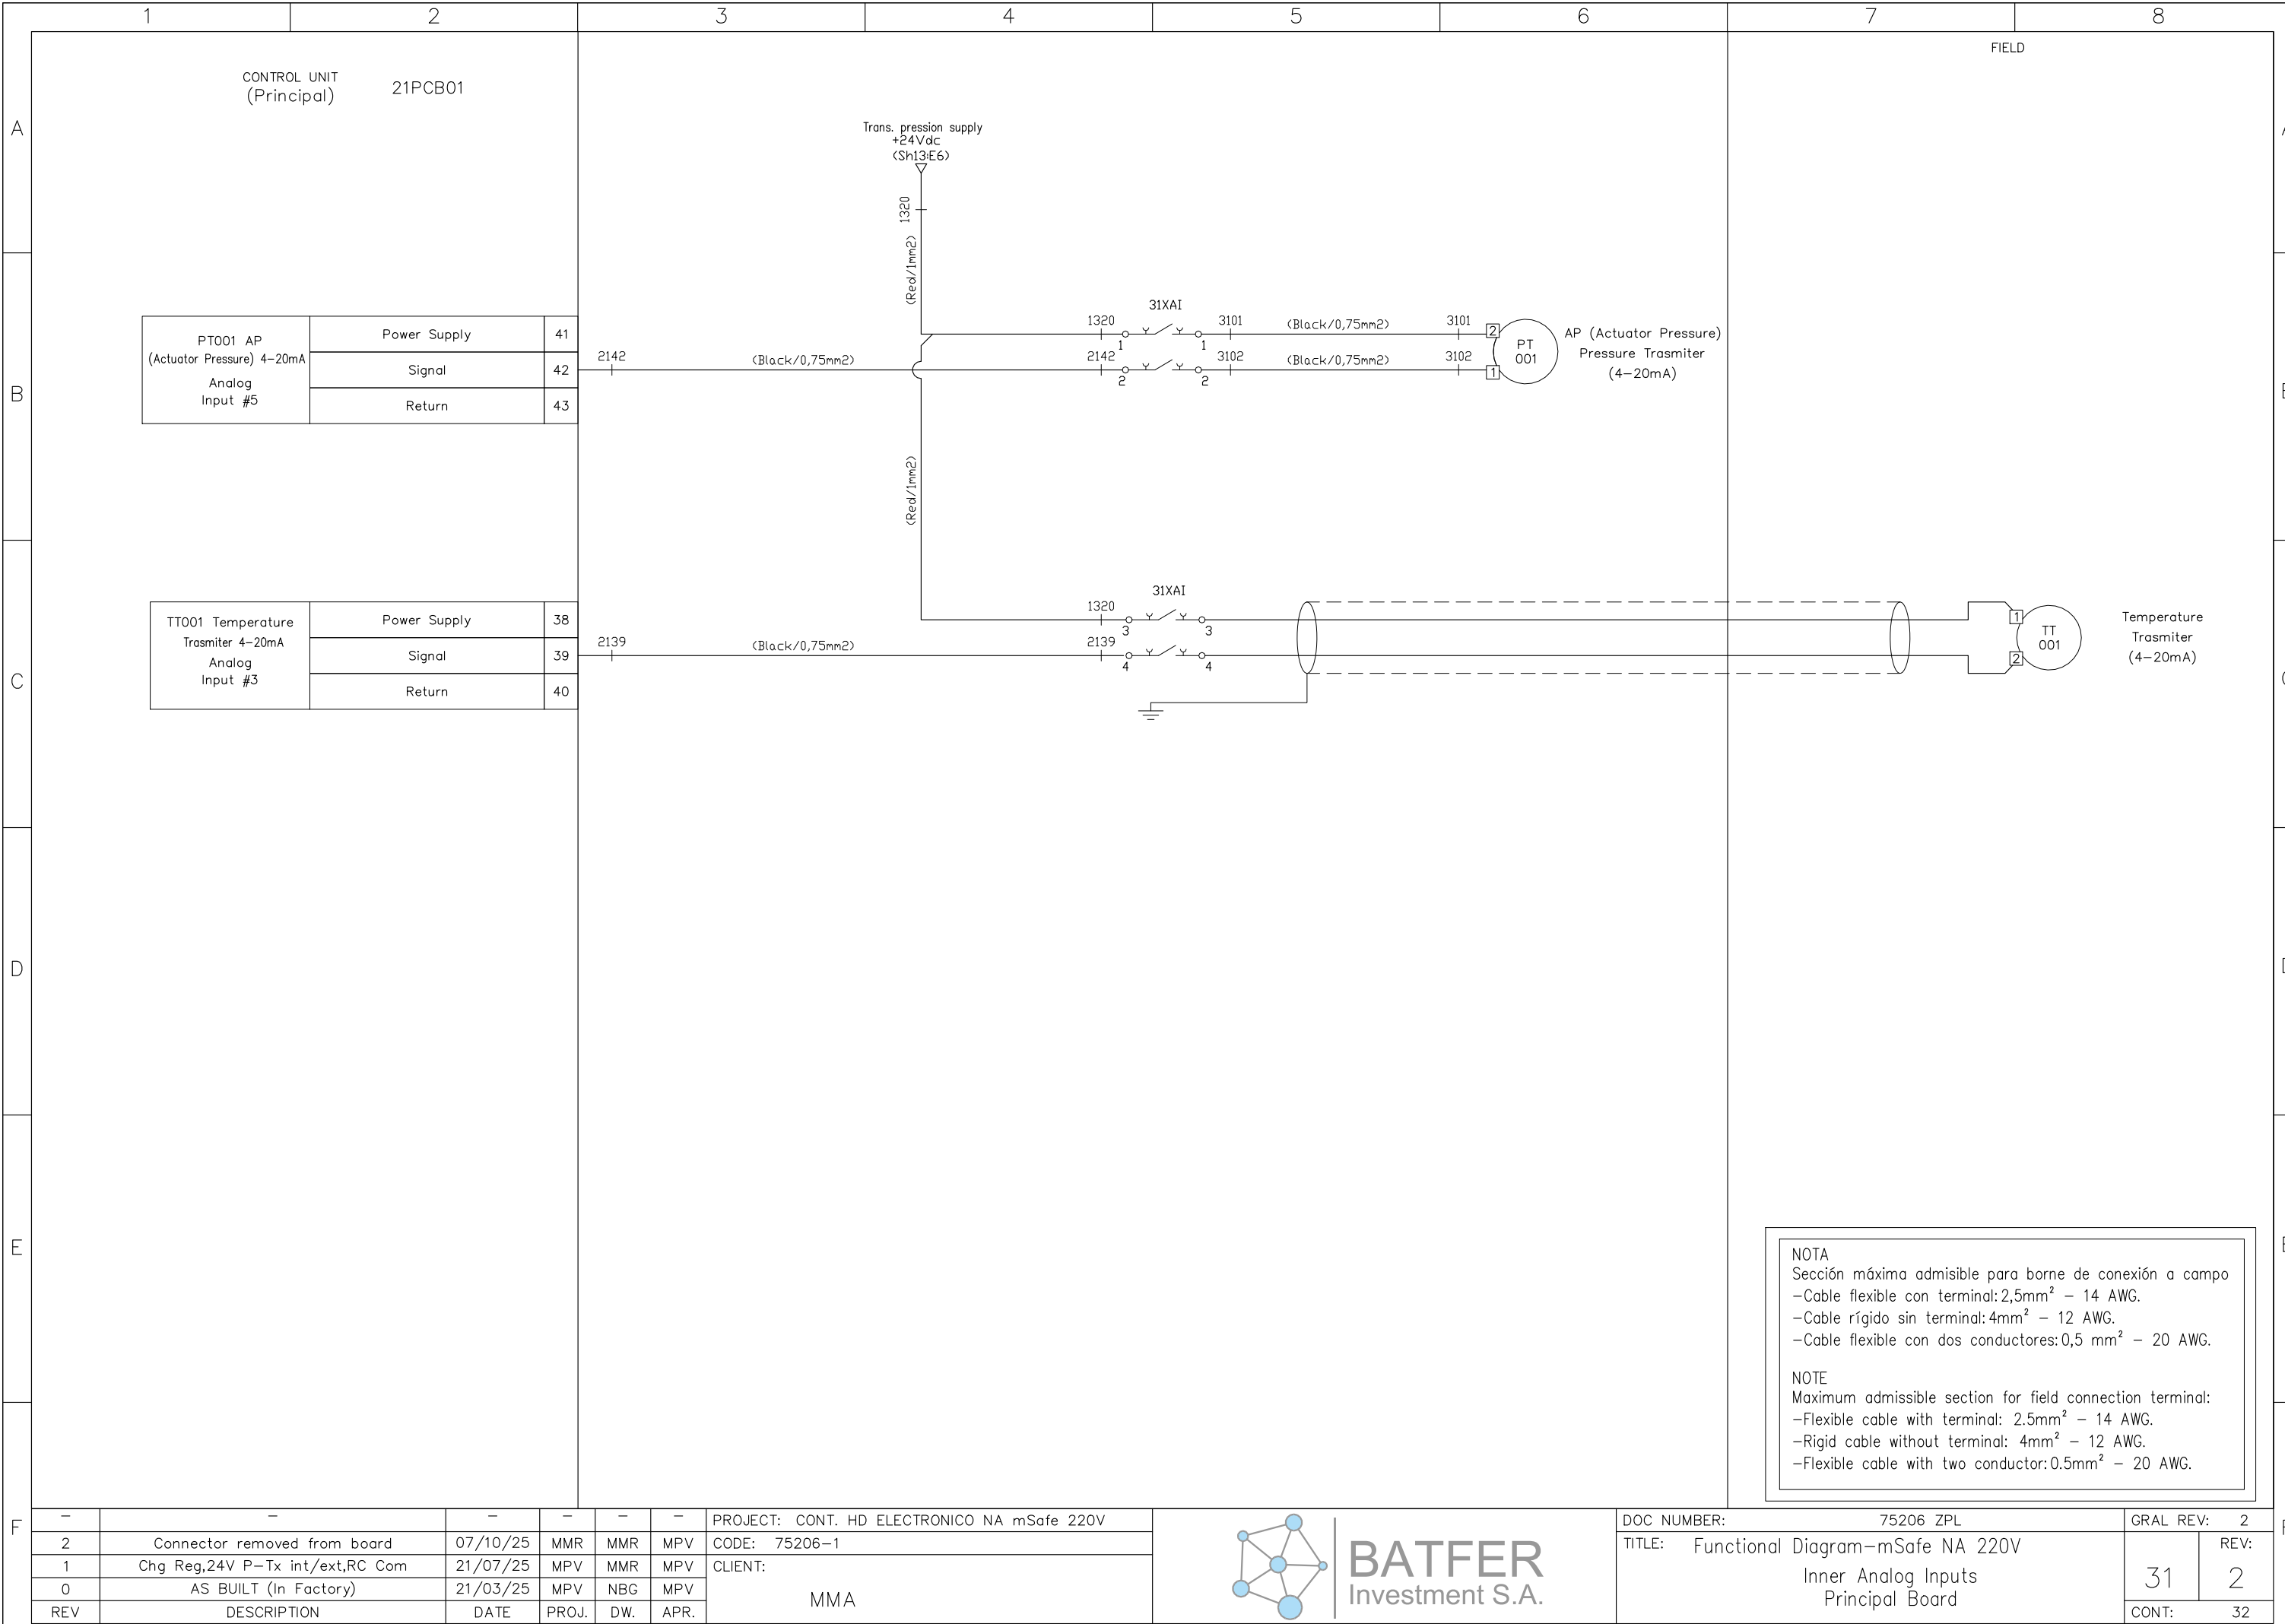


BATFER INVESTMENT S.A. RESERVES THE OWNERSHIP OF THIS DOCUMENT. IT IS PROHIBITED TO REPRODUCE, MODIFY OR TRANSFER WITHOUT PRIOR WRITTEN AUTHORIZATION.

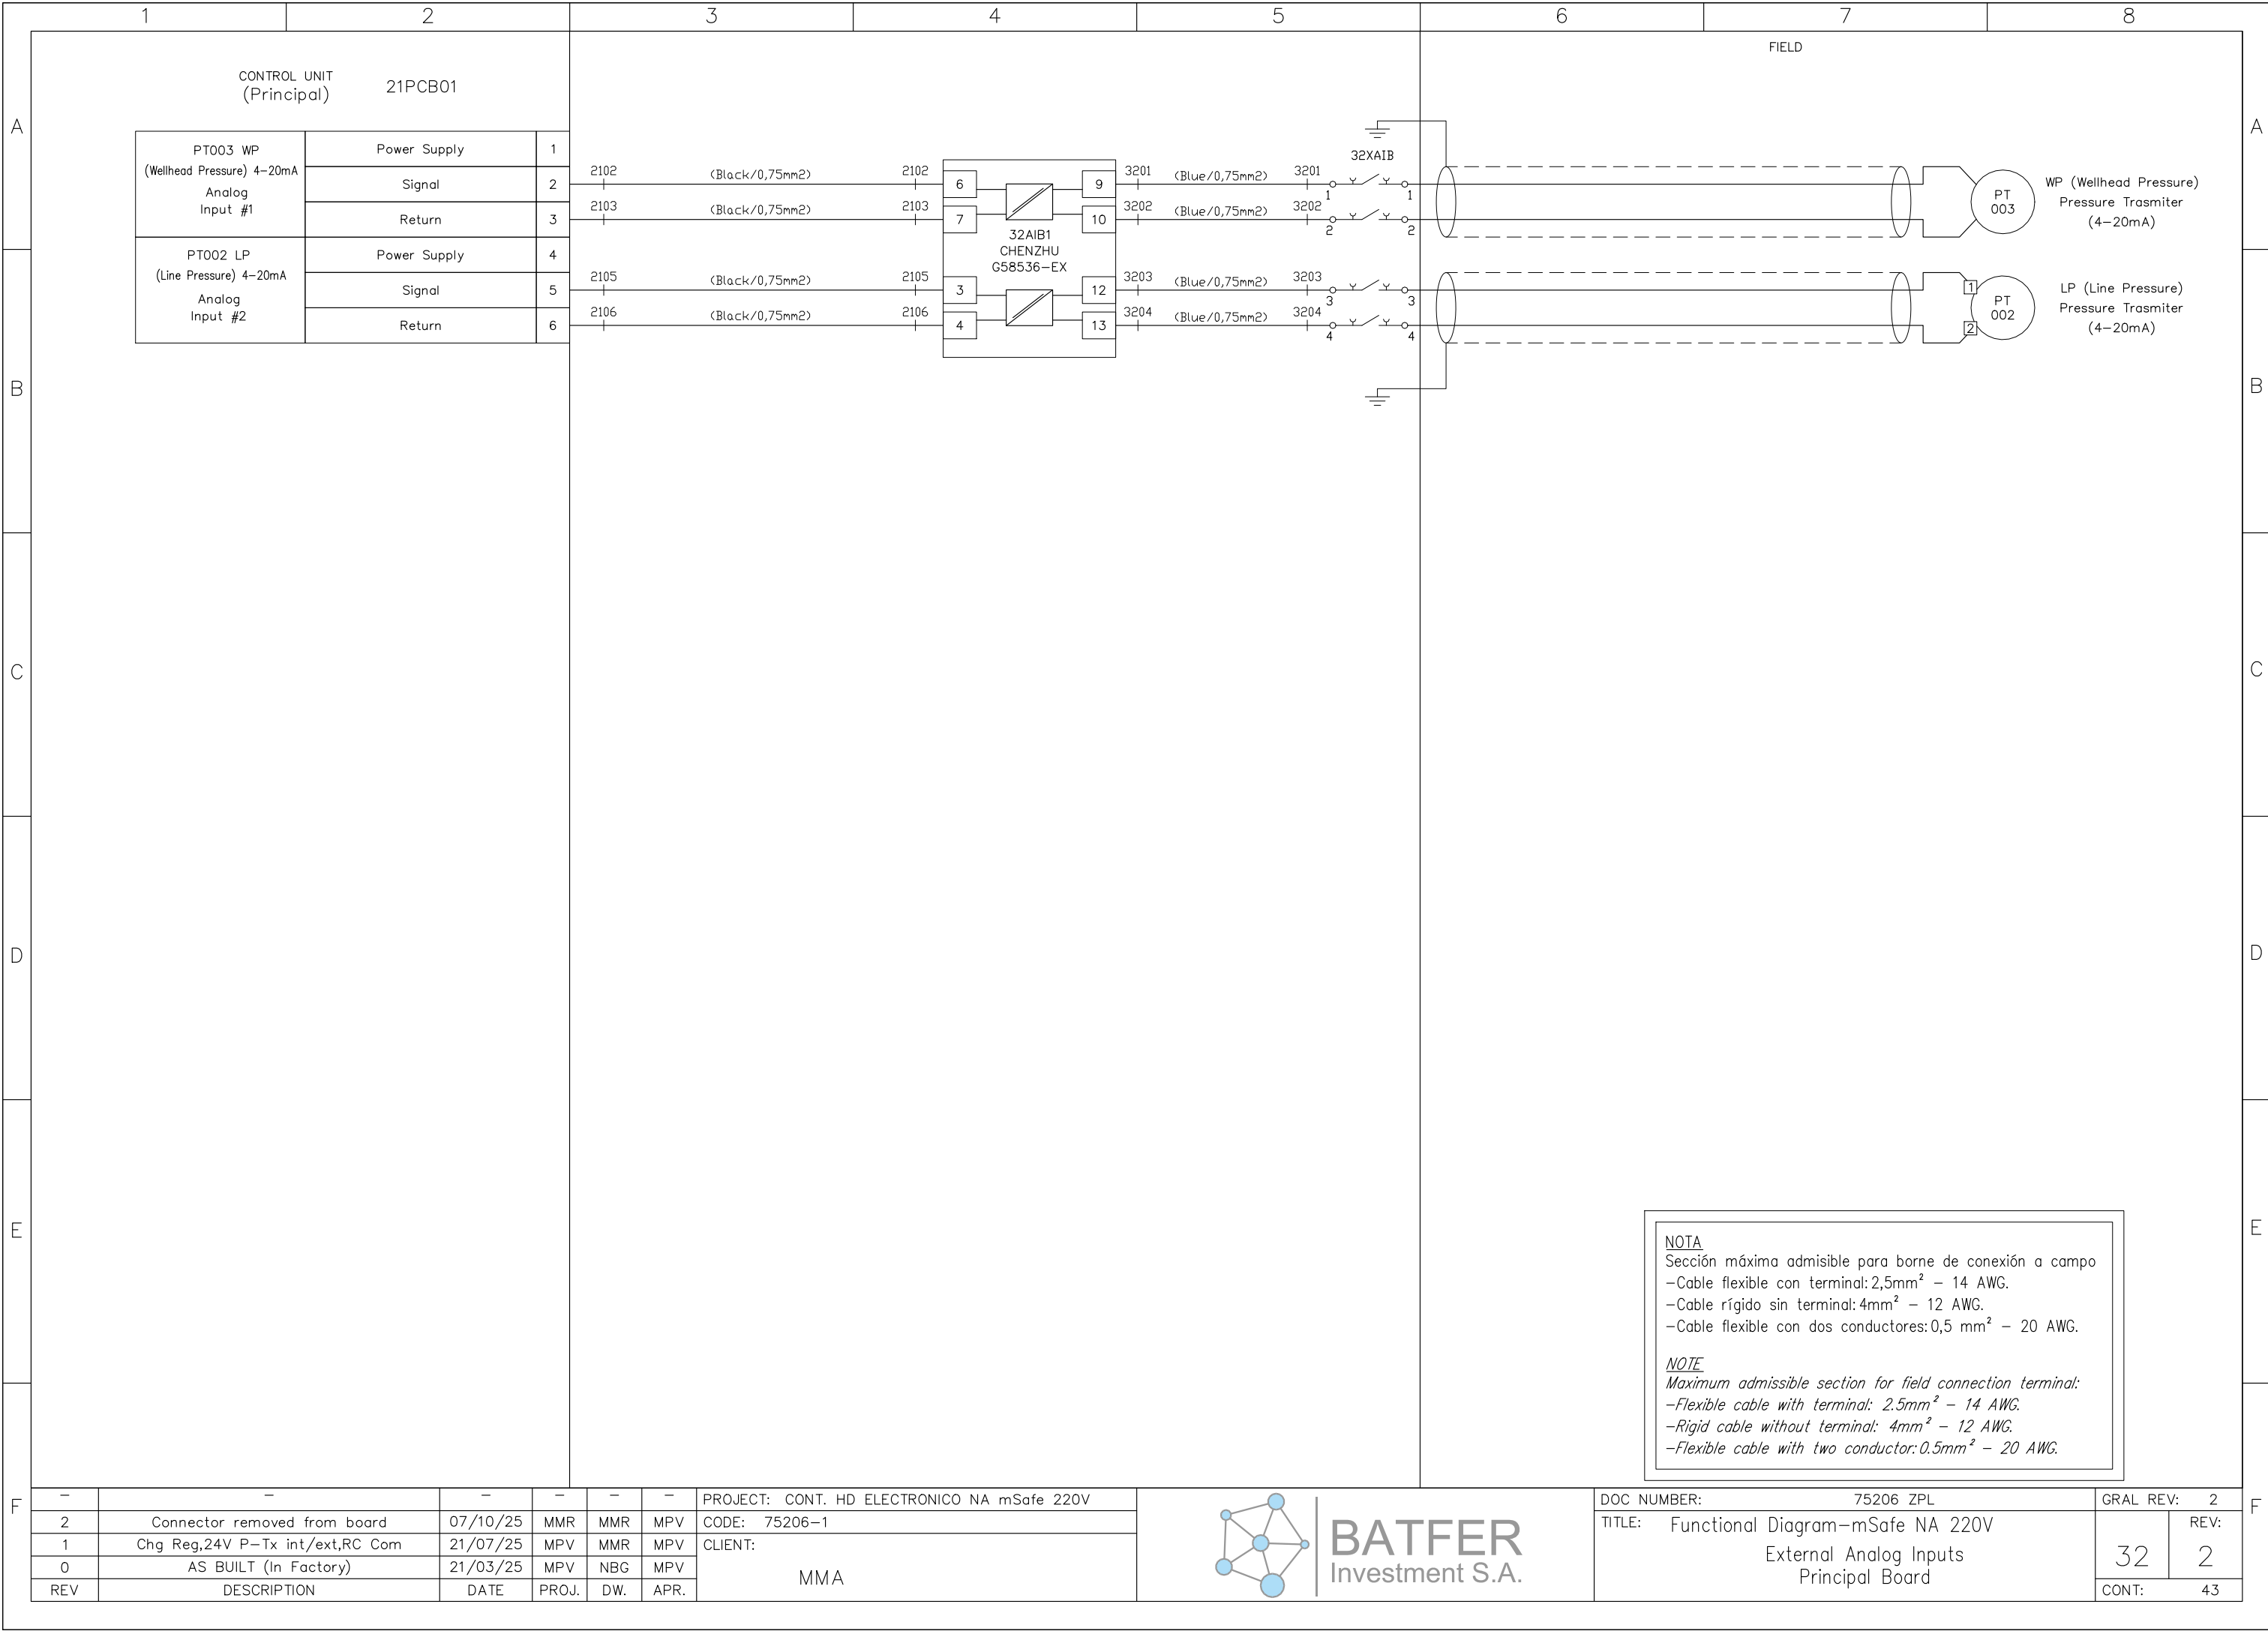


BATFER INVESTMENT S.A. RESERVES THE OWNERSHIP OF THIS DOCUMENT. IT IS PROHIBITED TO REPRODUCE, MODIFY OR TRANSFER WITHOUT PRIOR WRITTEN AUTHORIZATION.

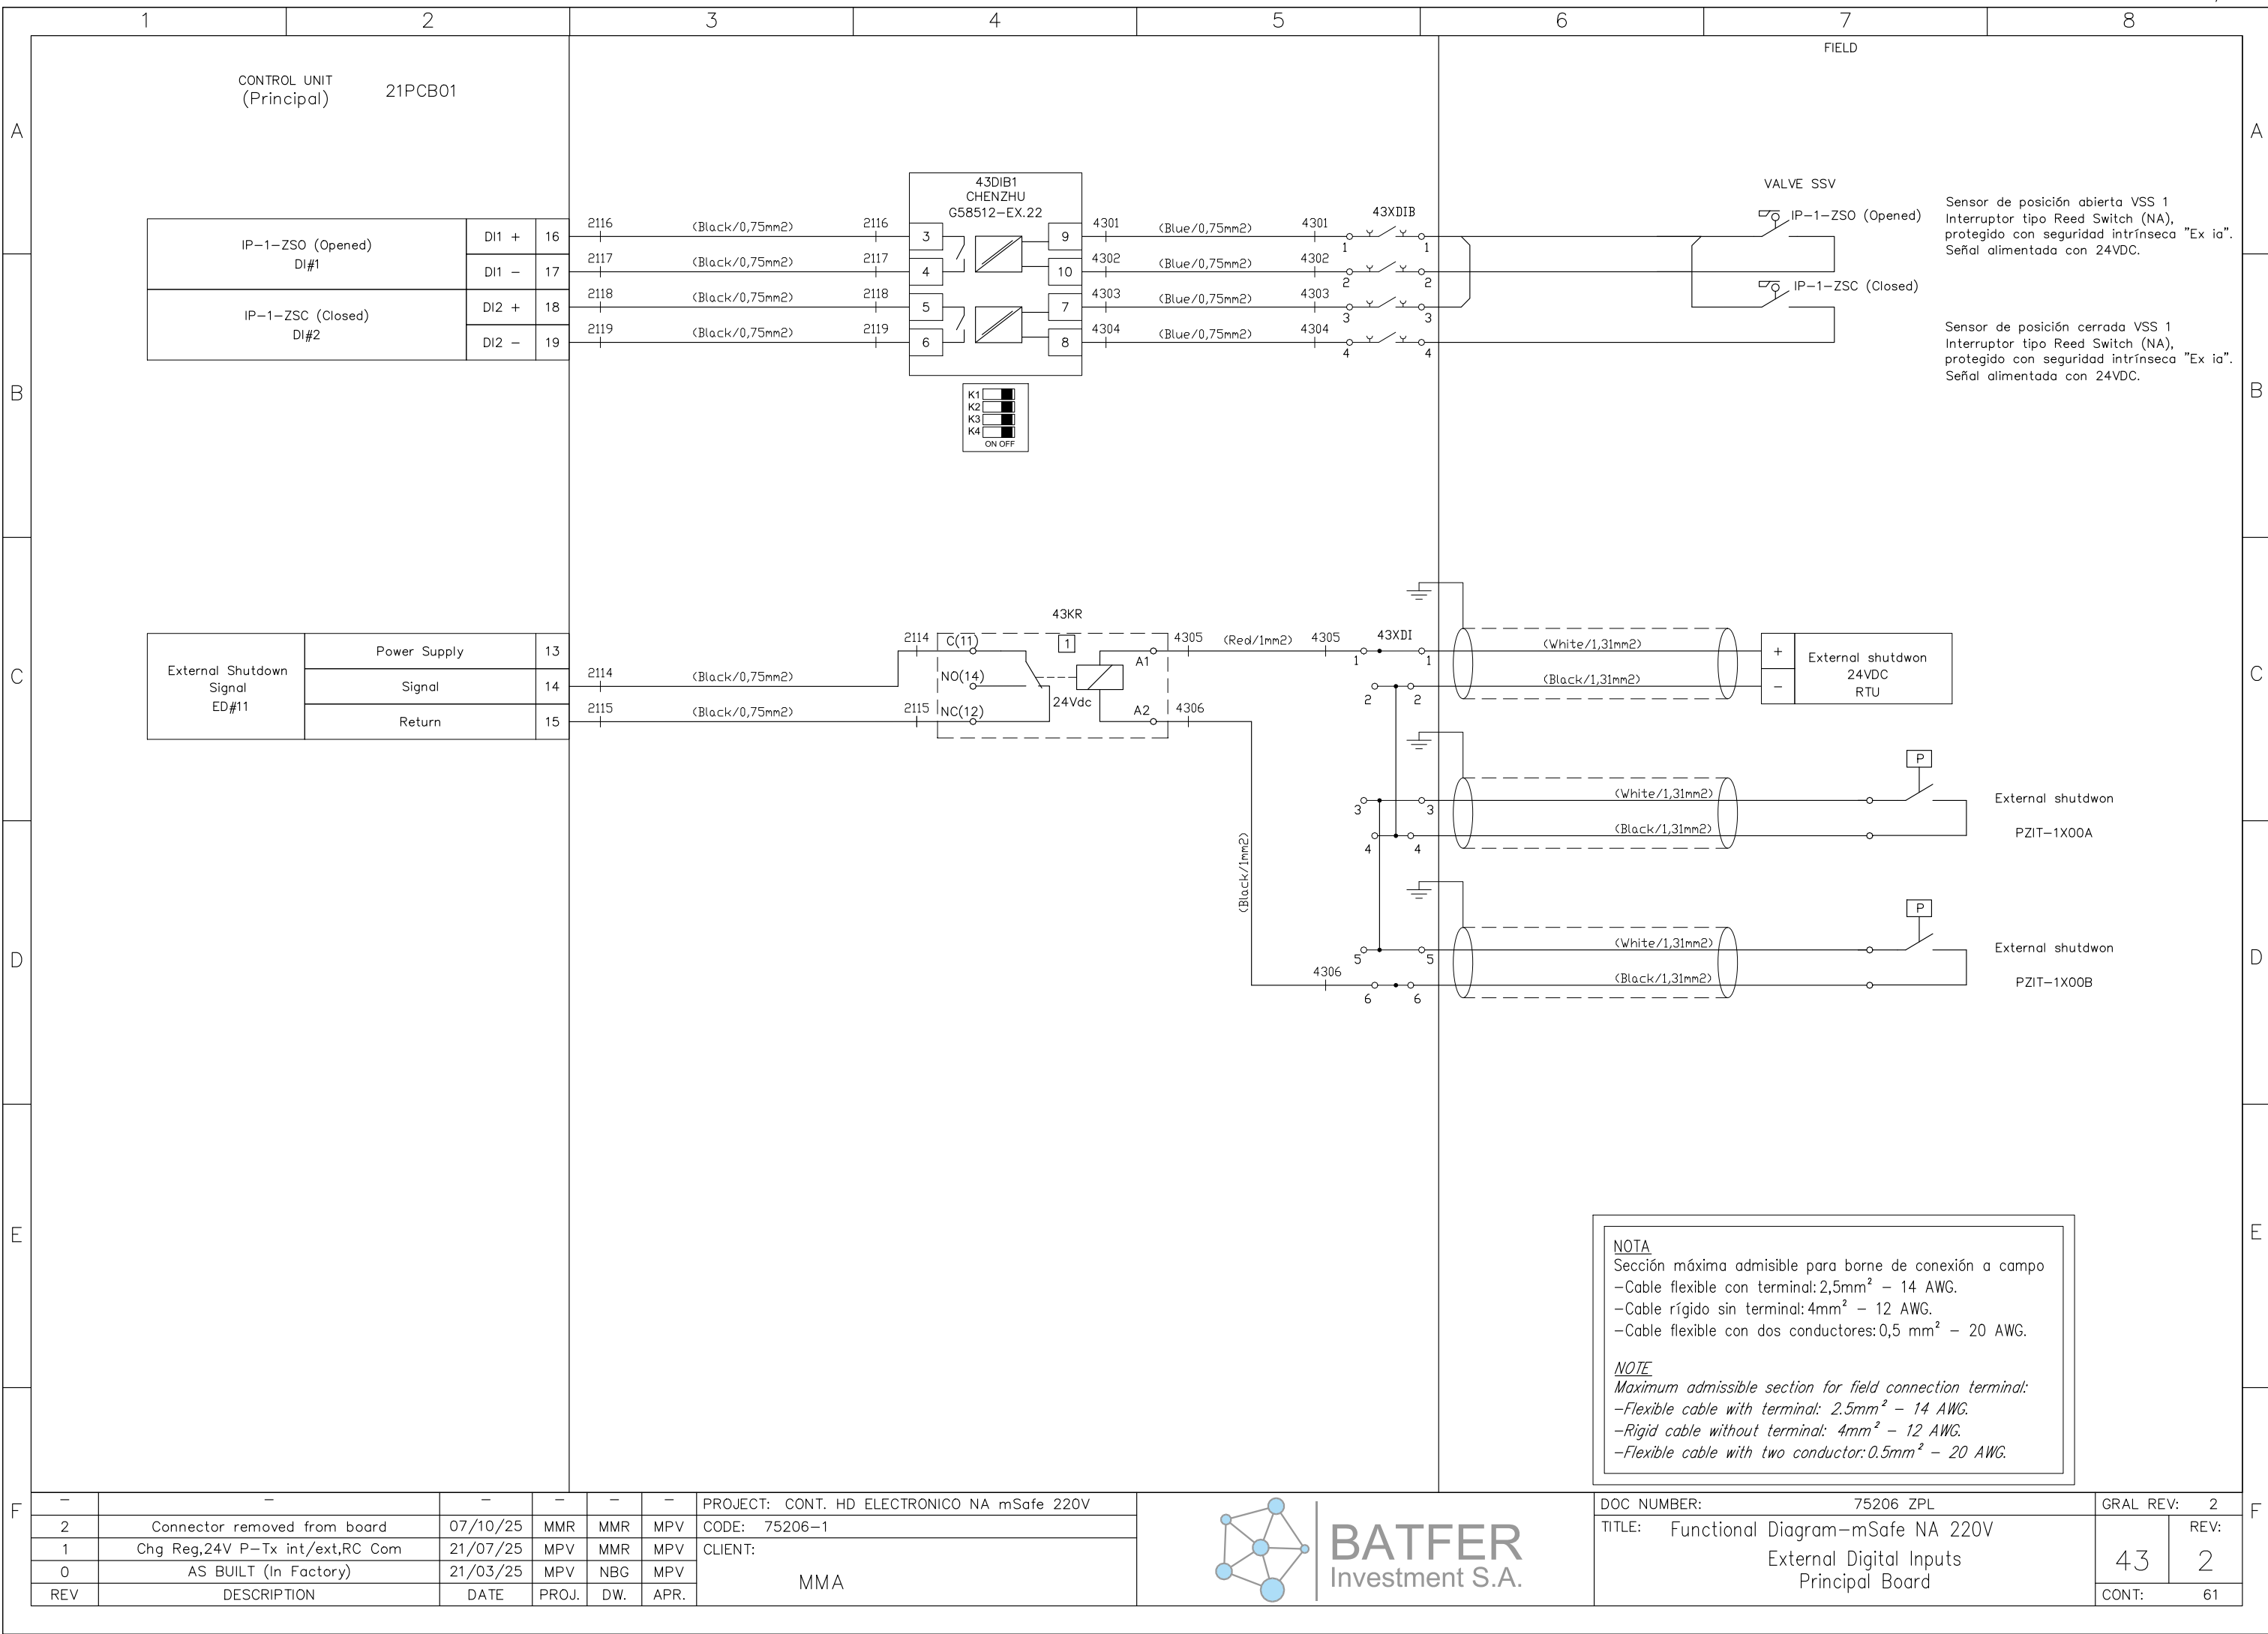

BATFER INVESTMENT S.A. RESERVES THE OWNERSHIP OF THIS DOCUMENT. IT IS PROHIBITED TO REPRODUCE, MODIFY OR TRANSFER WITHOUT PRIOR WRITTEN AUTHORIZATION.

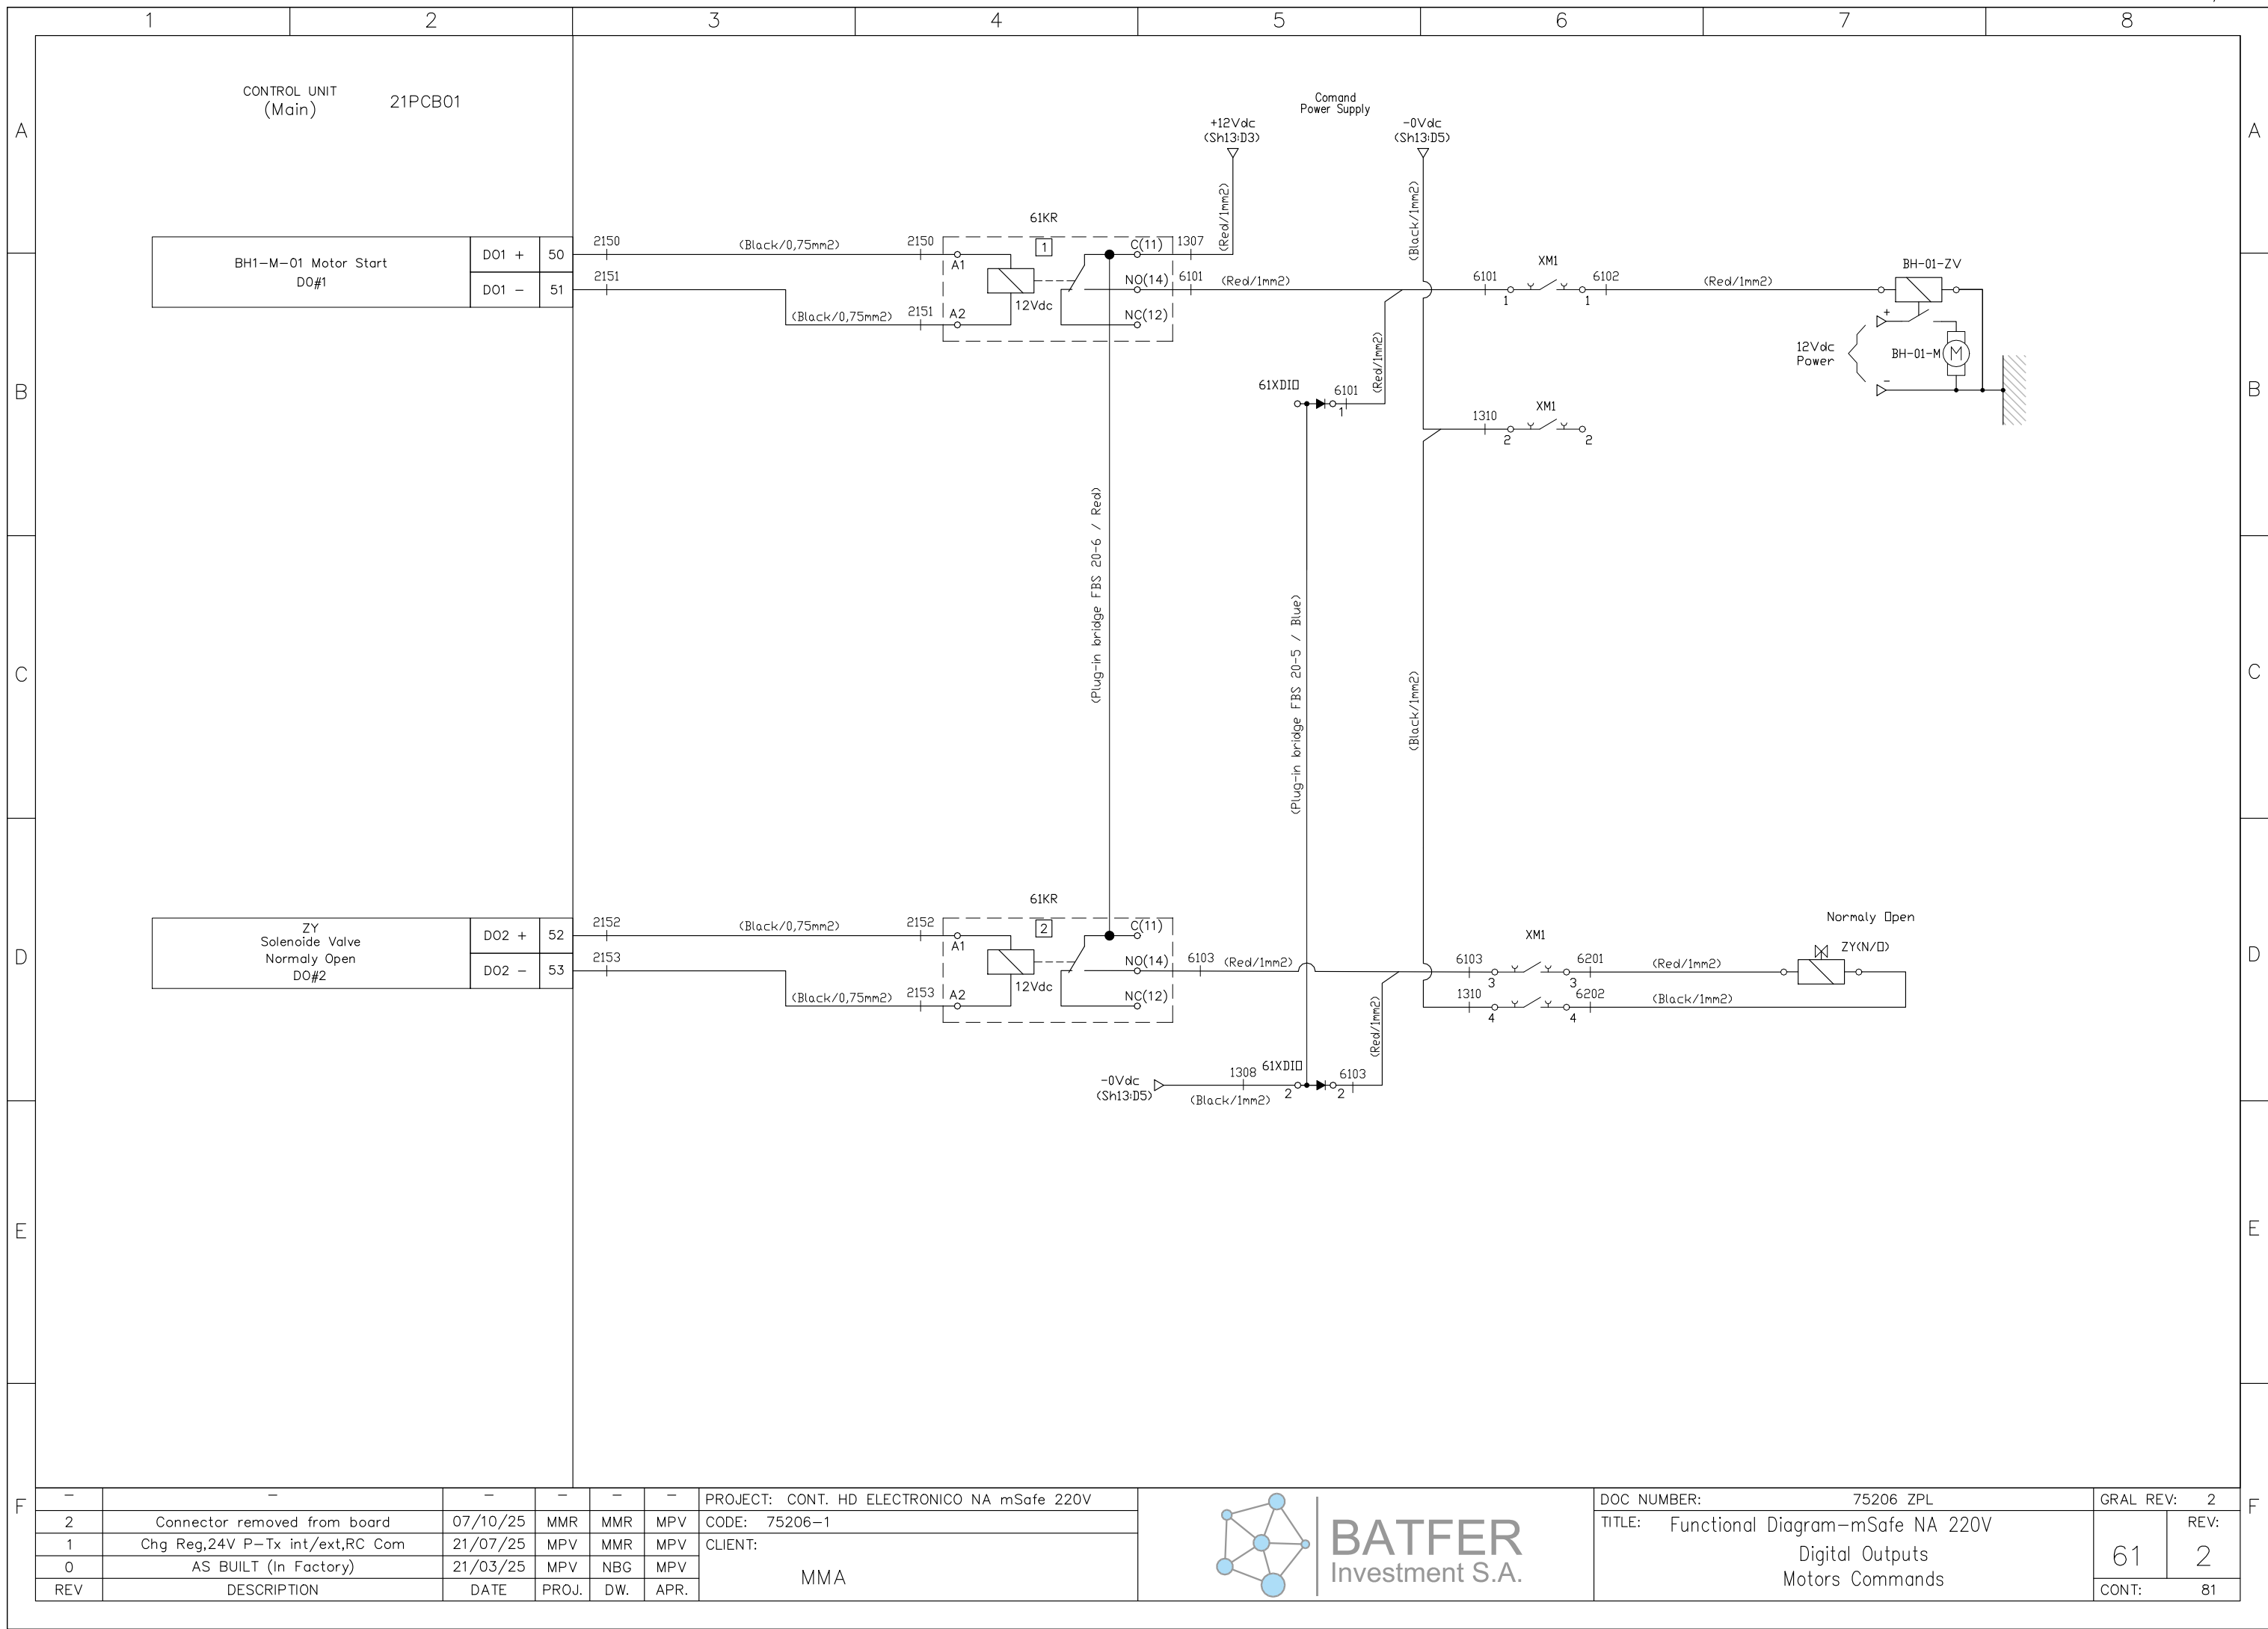

-	-	-	-	-	-	PROJECT: CONT. HD ELECTRONICO NA mSafe 220V	 BATFER Investment S.A.	DOC NUMBER: 75206 ZPL		GRAL REV: 2	
2	Connector removed from board	07/10/25	MMR	MMR	MPV	CODE: 75206-1		TITLE: Functional Diagram-mSafe NA 220V		REV: 61	
1	Chg Reg,24V P-Tx int/ext,RC Com	21/07/25	MPV	MMR	MPV	CLIENT: MMA		Digital Outputs		2	
0	AS BUILT (In Factory)	21/03/25	MPV	NBG	MPV			Motors Commands		81	
REV	DESCRIPTION	DATE	PROJ.	DW.	APR.						

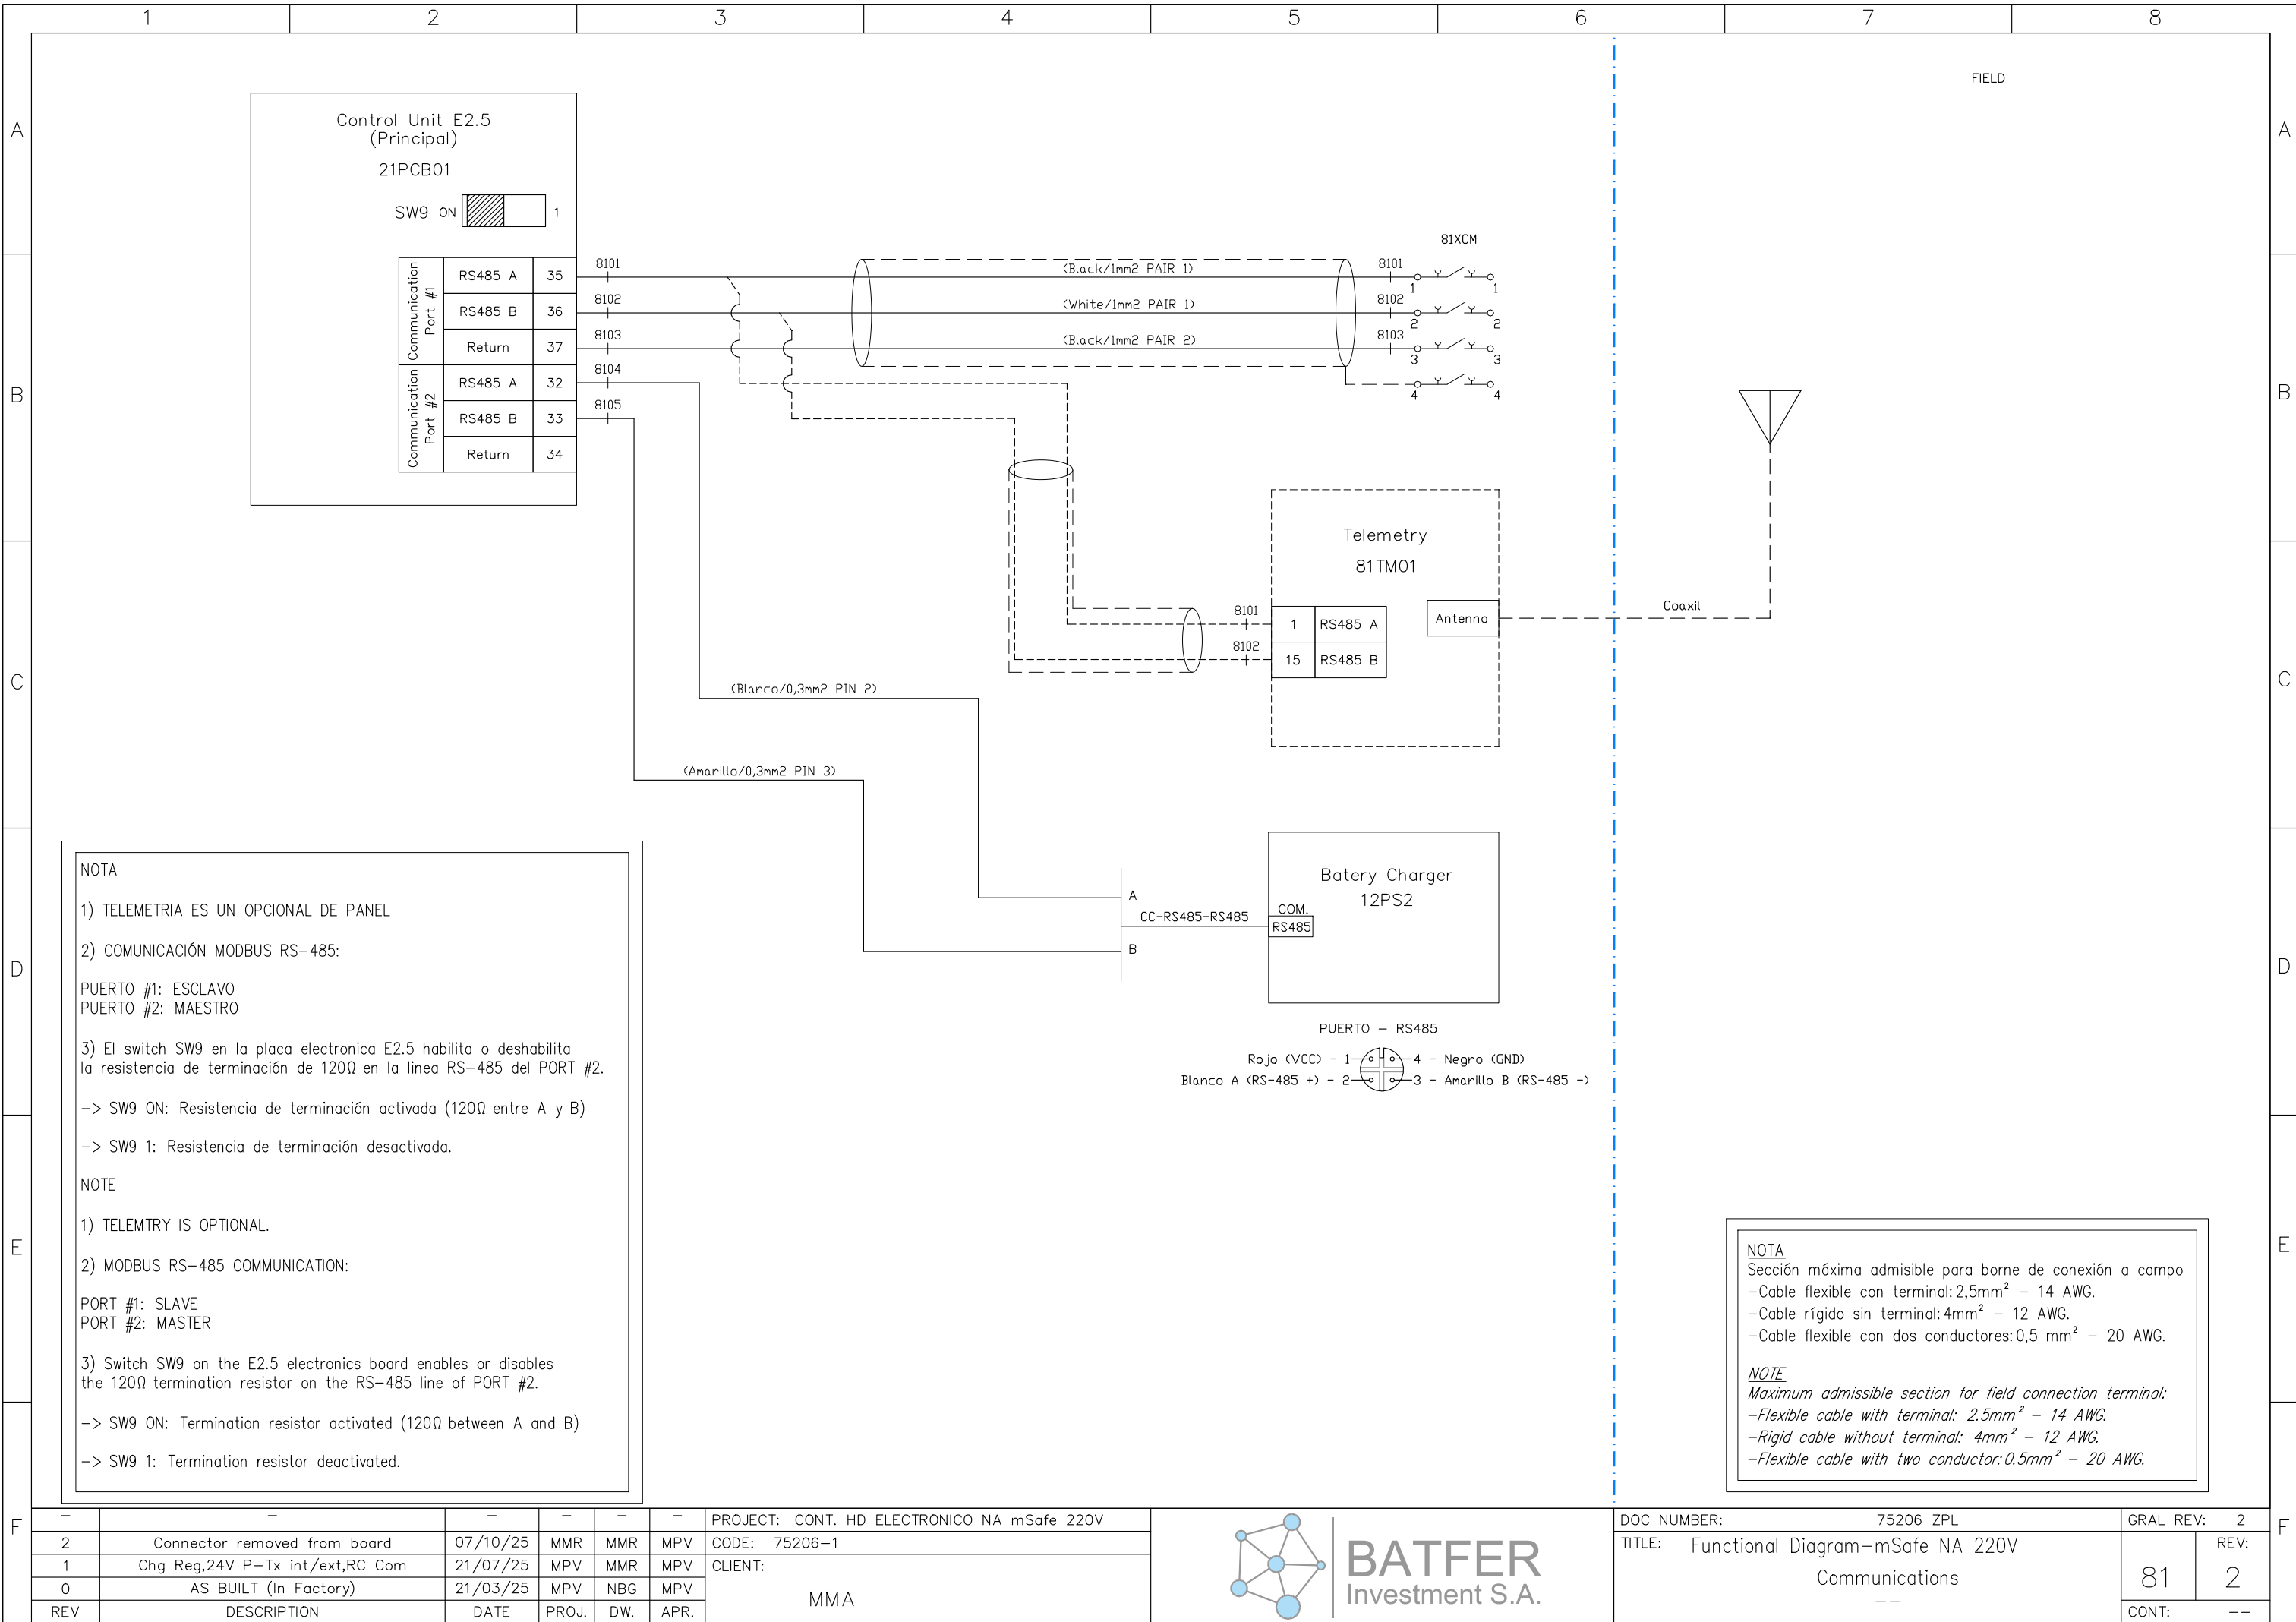

BATFER

Investment S.A.

DOC NUMBER:

75206 ZPL

TITLE:

Functional Diagram-mSafe NA 220V Communications

GRAL REV:

2

REV:

2

CONT:

--

PROJECT: CONT. HD ELECTRONICO NA mSafe 220V

CODE: 75206-1

CLIENT: MMA

2

Connector removed from board

07/10/25

MMR

MMR

MPV

1

Chg Reg,24V P-Tx int/ext,RC Com

21/07/25

MPV

MMR

MPV

0

AS BUILT (In Factory)

21/03/25

MPV

NBG

MPV

REV

DESCRIPTION

DATE

PROJ.

DW.

APR.