
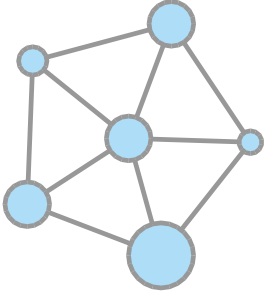
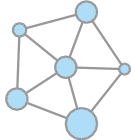
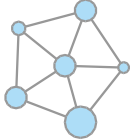


MMA S.A. OWNERSHIP OF THIS DOCUMENT IS RESERVED. IT IS PROHIBITED TO REPRODUCE, MODIFY OR TRANSFER WITHOUT PRIOR WRITTEN AUTHORIZATION.

1	2	3	4	5	6	7	8																																				
A								A																																			
B	 BATFER Investment S.A.							B																																			
C								C																																			
D	Client: - MMA Project: - mSafe Tecpetrol Description Document: - 72715-1 Structure and Arrangement Diagram Document Number: - 50000000000000072887 ZPL Revision: - 3					APROBADO PARA PRODUCCION APROBADO:MPV FECHA: 09-06-2025  BATFER Investment S.A.		D																																			
E	Installation Place -							E																																			
F	<table><tr><td>3</td><td>Se agrega borne 16XC</td><td>09/06/25</td><td>MMR</td><td>MMR</td><td>MPV</td><td>PROYECTO:mSafe Tecpetrol</td></tr><tr><td>2</td><td>Se agrega 13XC2,16XC;Modif. BH-01-M</td><td>09/12/24</td><td>MMR</td><td>MMR</td><td>MPV</td><td>CÓDIGO: 72715-1</td></tr><tr><td>1</td><td>Perforacion sobrepuerta</td><td>16/10/24</td><td>MMR</td><td>MMR</td><td>NBG</td><td>CLIENTE:</td></tr><tr><td>0</td><td>AsBuilt (in Factory)</td><td>17/01/24</td><td>NBG</td><td>NBG</td><td>MPV</td><td>MMA</td></tr><tr><td>REV</td><td>DESCRIPCION</td><td>FECHA</td><td>PROY.</td><td>DIBUJÓ</td><td>APROB.</td><td></td></tr></table>					3	Se agrega borne 16XC	09/06/25	MMR	MMR	MPV	PROYECTO:mSafe Tecpetrol	2	Se agrega 13XC2,16XC;Modif. BH-01-M	09/12/24	MMR	MMR	MPV	CÓDIGO: 72715-1	1	Perforacion sobrepuerta	16/10/24	MMR	MMR	NBG	CLIENTE:	0	AsBuilt (in Factory)	17/01/24	NBG	NBG	MPV	MMA	REV	DESCRIPCION	FECHA	PROY.	DIBUJÓ	APROB.		 BATFER Investment S.A. N° DE DOC: 50000000000000072887 ZPL TITULO: Structure and Arrangement mSafe Constructivo Carátula REV. GRAL: 3 HOJA: 00 REVISIÓN: 3 CONTINÚA: 01		F
3	Se agrega borne 16XC	09/06/25	MMR	MMR	MPV	PROYECTO:mSafe Tecpetrol																																					
2	Se agrega 13XC2,16XC;Modif. BH-01-M	09/12/24	MMR	MMR	MPV	CÓDIGO: 72715-1																																					
1	Perforacion sobrepuerta	16/10/24	MMR	MMR	NBG	CLIENTE:																																					
0	AsBuilt (in Factory)	17/01/24	NBG	NBG	MPV	MMA																																					
REV	DESCRIPCION	FECHA	PROY.	DIBUJÓ	APROB.																																						

MMA S.A. OWNERSHIP OF THIS DOCUMENT IS RESERVED. IT IS PROHIBITED TO REPRODUCE, MODIFY OR TRANSFER WITHOUT PRIOR WRITTEN AUTHORIZATION.

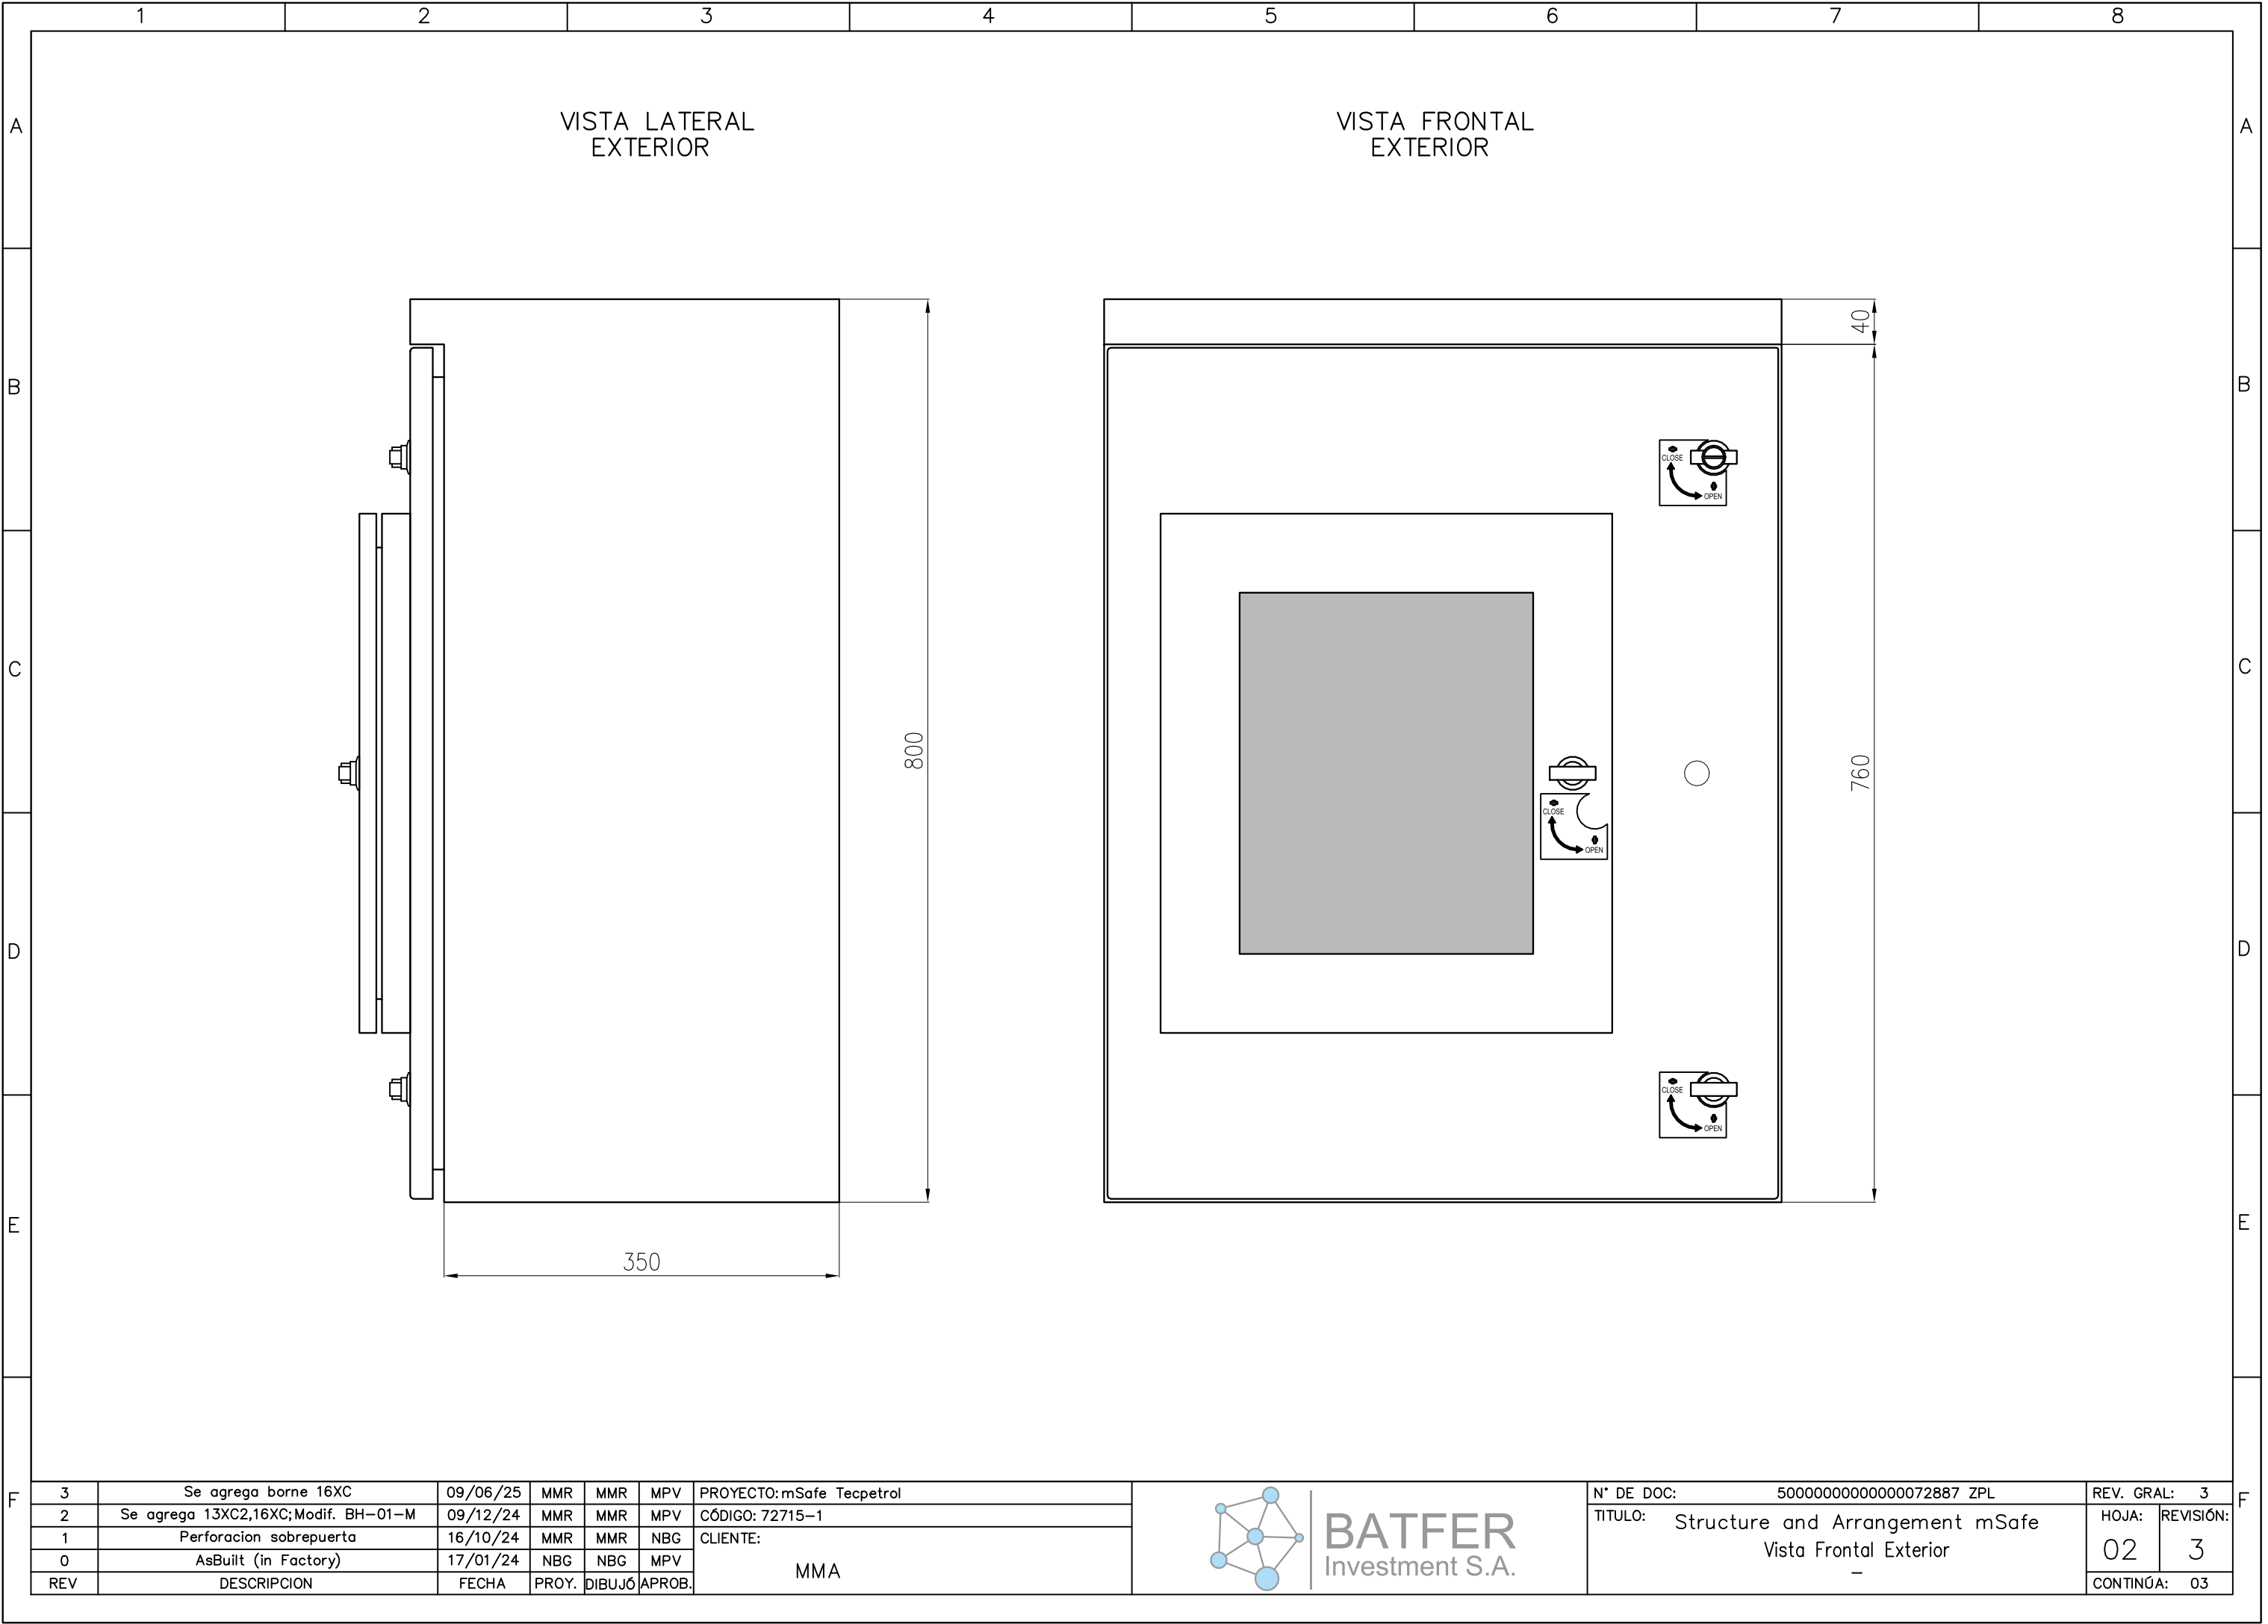

3	Se agrega borne 16XC	09/06/25	MMR	MMR	MPV
2	Se agrega 13XC2,16XC;Modif. BH-01-M	09/12/24	MMR	MMR	MPV
1	Perforacion sobrepuerta	16/10/24	MMR	MMR	NBG
0	AsBuilt (in Factory)	17/01/24	NBG	NBG	MPV
REV	DESCRIPCION	FECHA	PROY.	DIBUJÓ	APROB.

PROYECTO:mSafe Tecpetrol
CÓDIGO: 72715-1
CLIENTE: MMA




BATFER
Investment S.A.


N° DE DOC:	50000000000000072887 ZPL
TITULO:	Structure and Arrangement mSafe Vista Frontal Exterior
	-

REV. GRAL:	3
HOJA:	02
REVISIÓN:	3
CONTINÚA:	03


VISTA LATERAL IZQUIERDA
INTERIOR

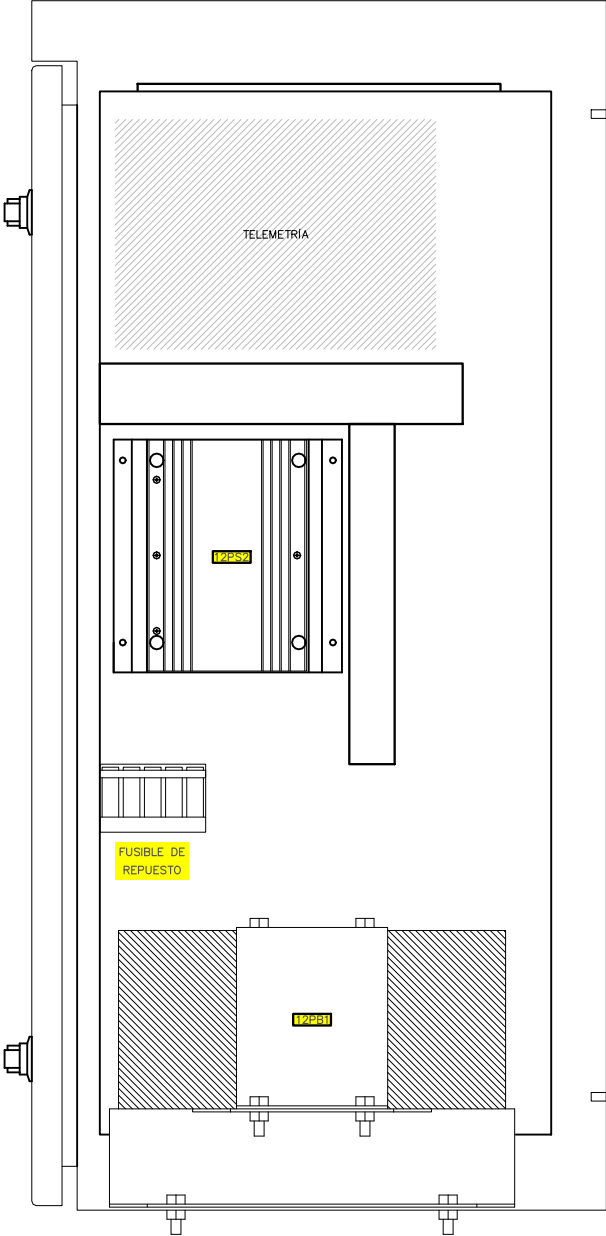

VISTA FONDO
INTERIOR

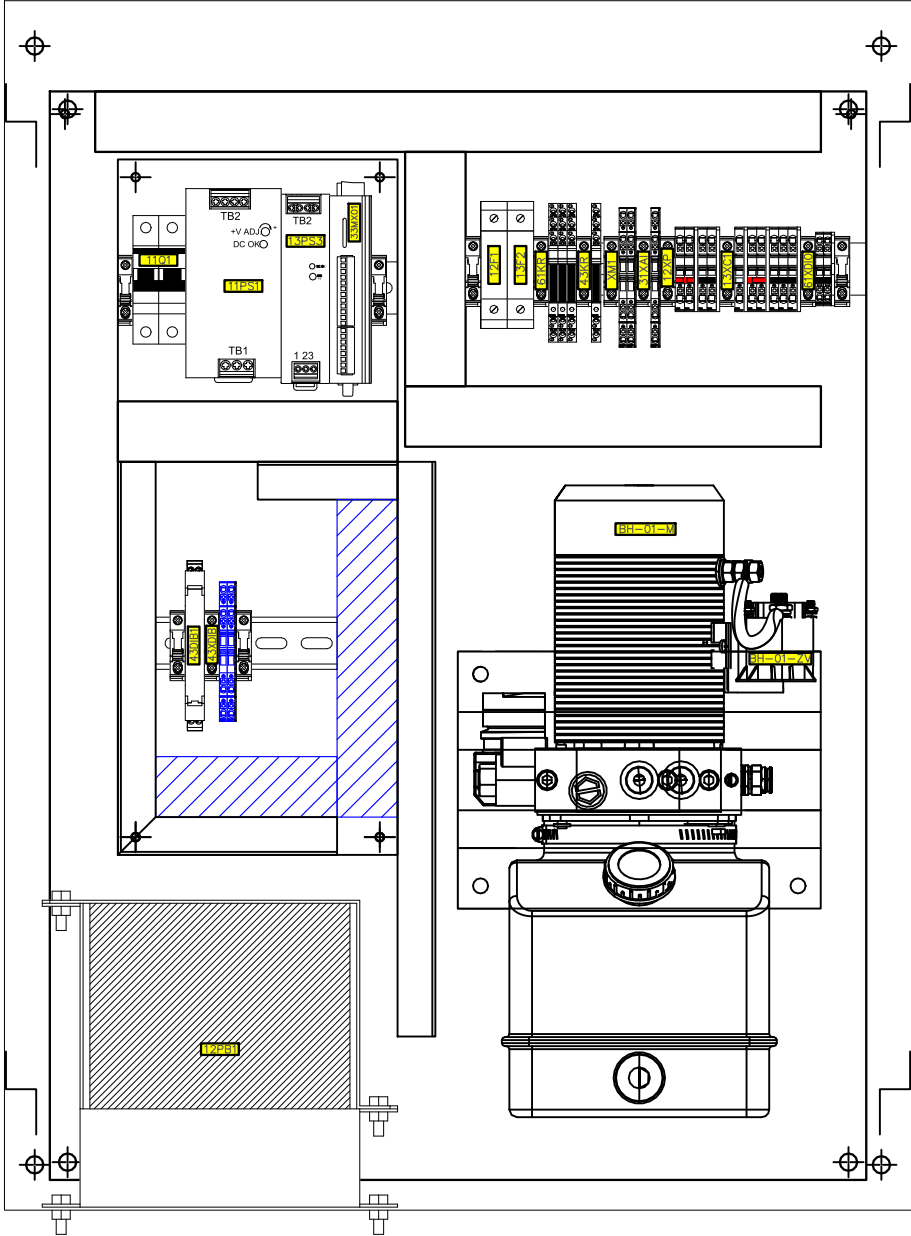

VISTA LATERAL DERECHA
INTERIOR

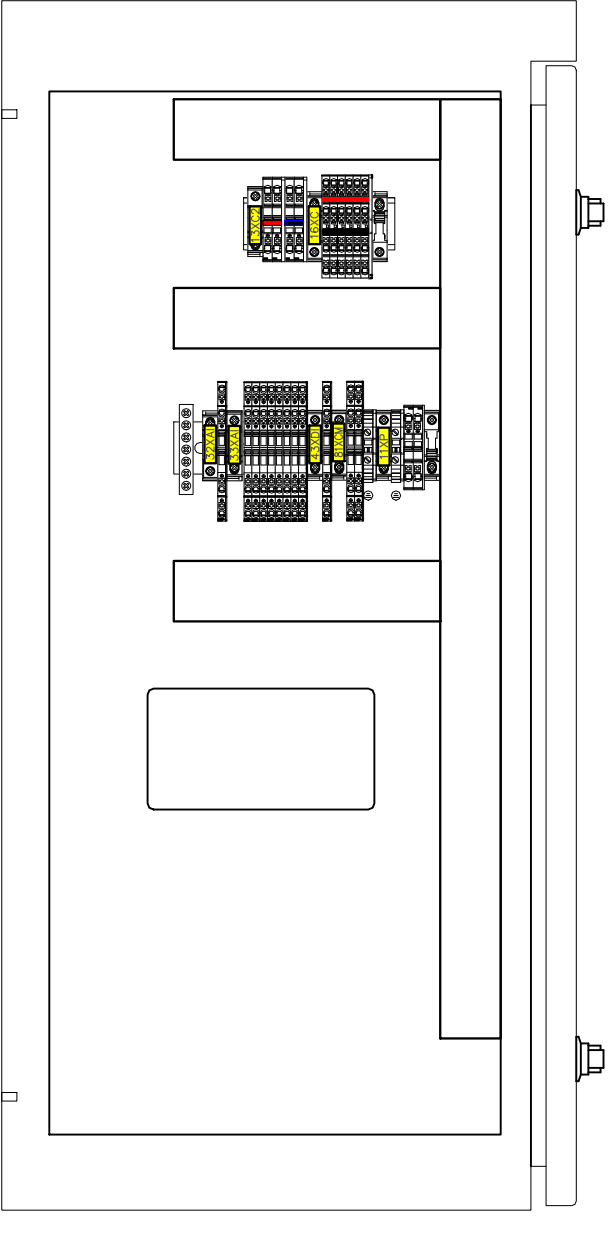

MMA S.A. OWNERSHIP OF THIS DOCUMENT IS RESERVED. IT IS PROHIBITED TO REPRODUCE, MODIFY OR TRANSFER WITHOUT PRIOR WRITTEN AUTHORIZATION.


3	Se agrega borne 16XC	09/06/25	MMR	MMR	MPV
2	Se agrega 13XC2,16XC;Modif. BH-01-M	09/12/24	MMR	MMR	MPV
1	Perforacion sobrepuerta	16/10/24	MMR	MMR	NBG
0	AsBuilt (in Factory)	17/01/24	NBG	NBG	MPV
REV	DESCRIPCION	FECHA	PROY.	DIBUJO	APROB.

PROYECTO:mSafe Tecpetrol
CÓDIGO: 72715-1
CLIENTE:
MMA




N° DE DOC:	5000000000000072887 ZPL	REV. GRAL:	3
TITULO:	Structure and Arrangement mSafe Detalle de Aparamenta	HOJA:	03
		REVISIÓN:	3
		CONTINÚA:	04


MMA S.A. OWNERSHIP OF THIS DOCUMENT IS RESERVED. IT IS PROHIBITED TO REPRODUCE, MODIFY OR TRANSFER WITHOUT PRIOR WRITTEN AUTHORIZATION.

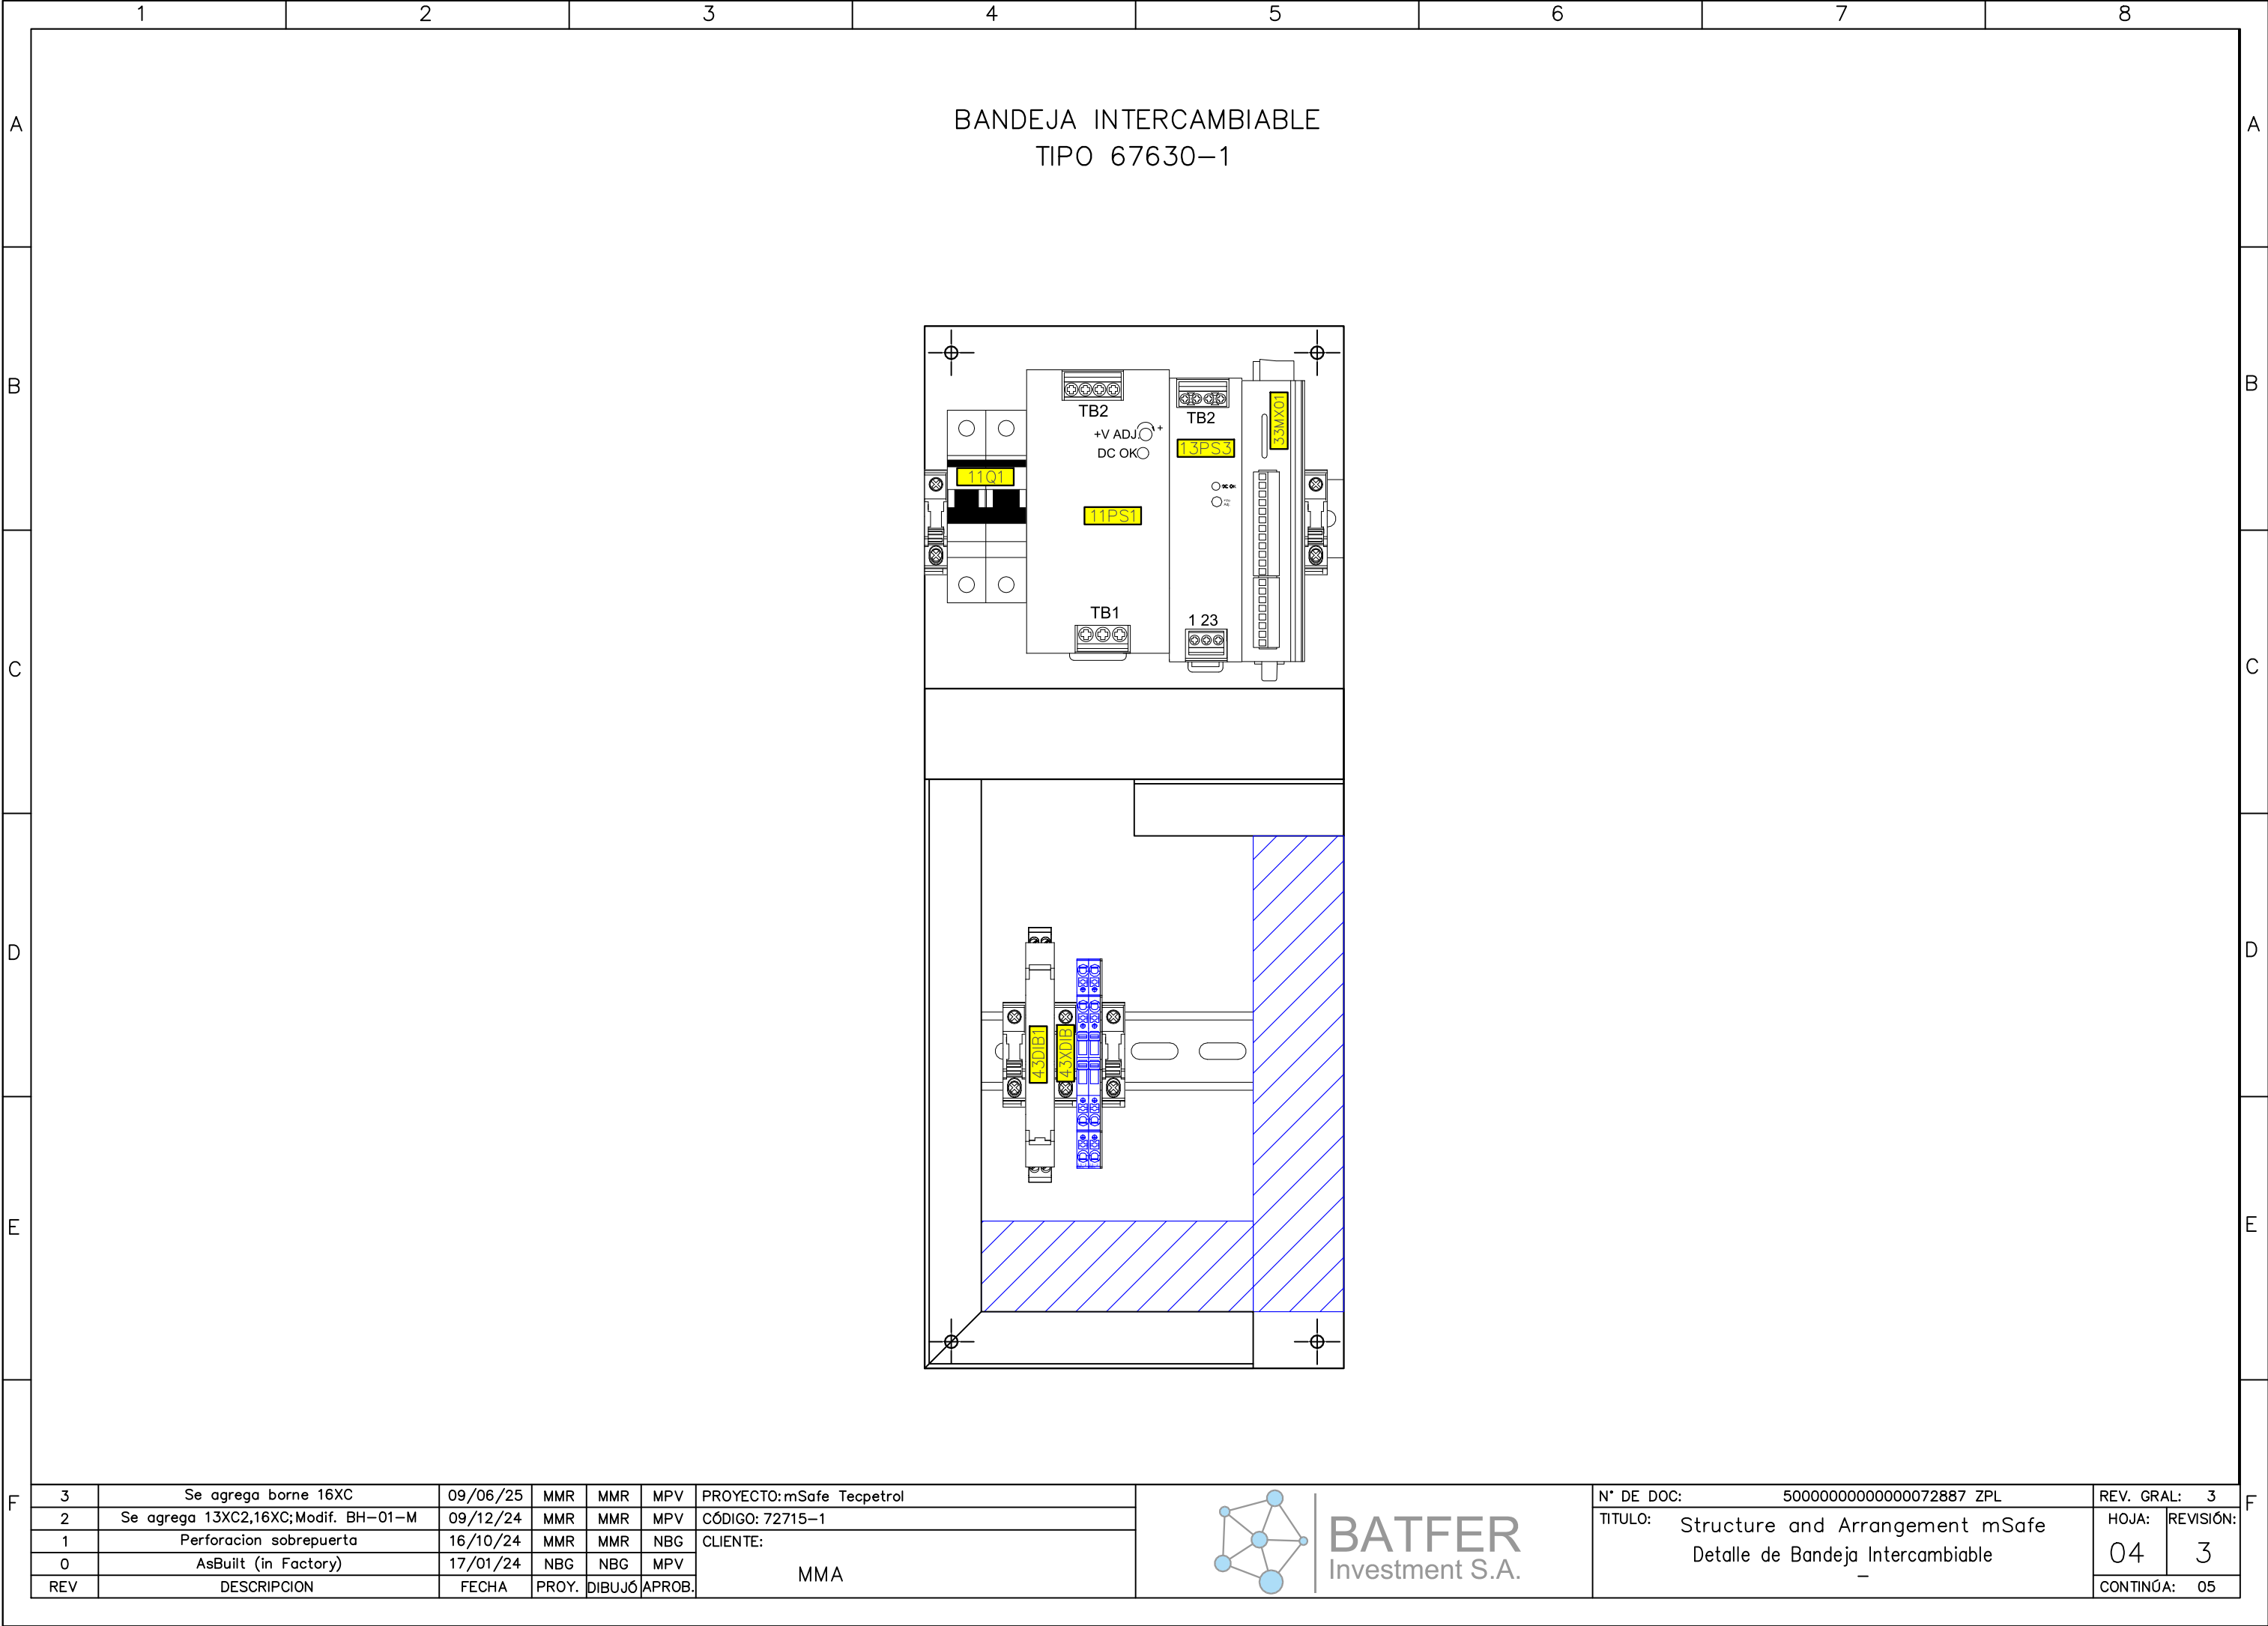

MMA S.A. OWNERSHIP OF THIS DOCUMENT IS RESERVED. IT IS PROHIBITED TO REPRODUCE, MODIFY OR TRANSFER WITHOUT PRIOR WRITTEN AUTHORIZATION.

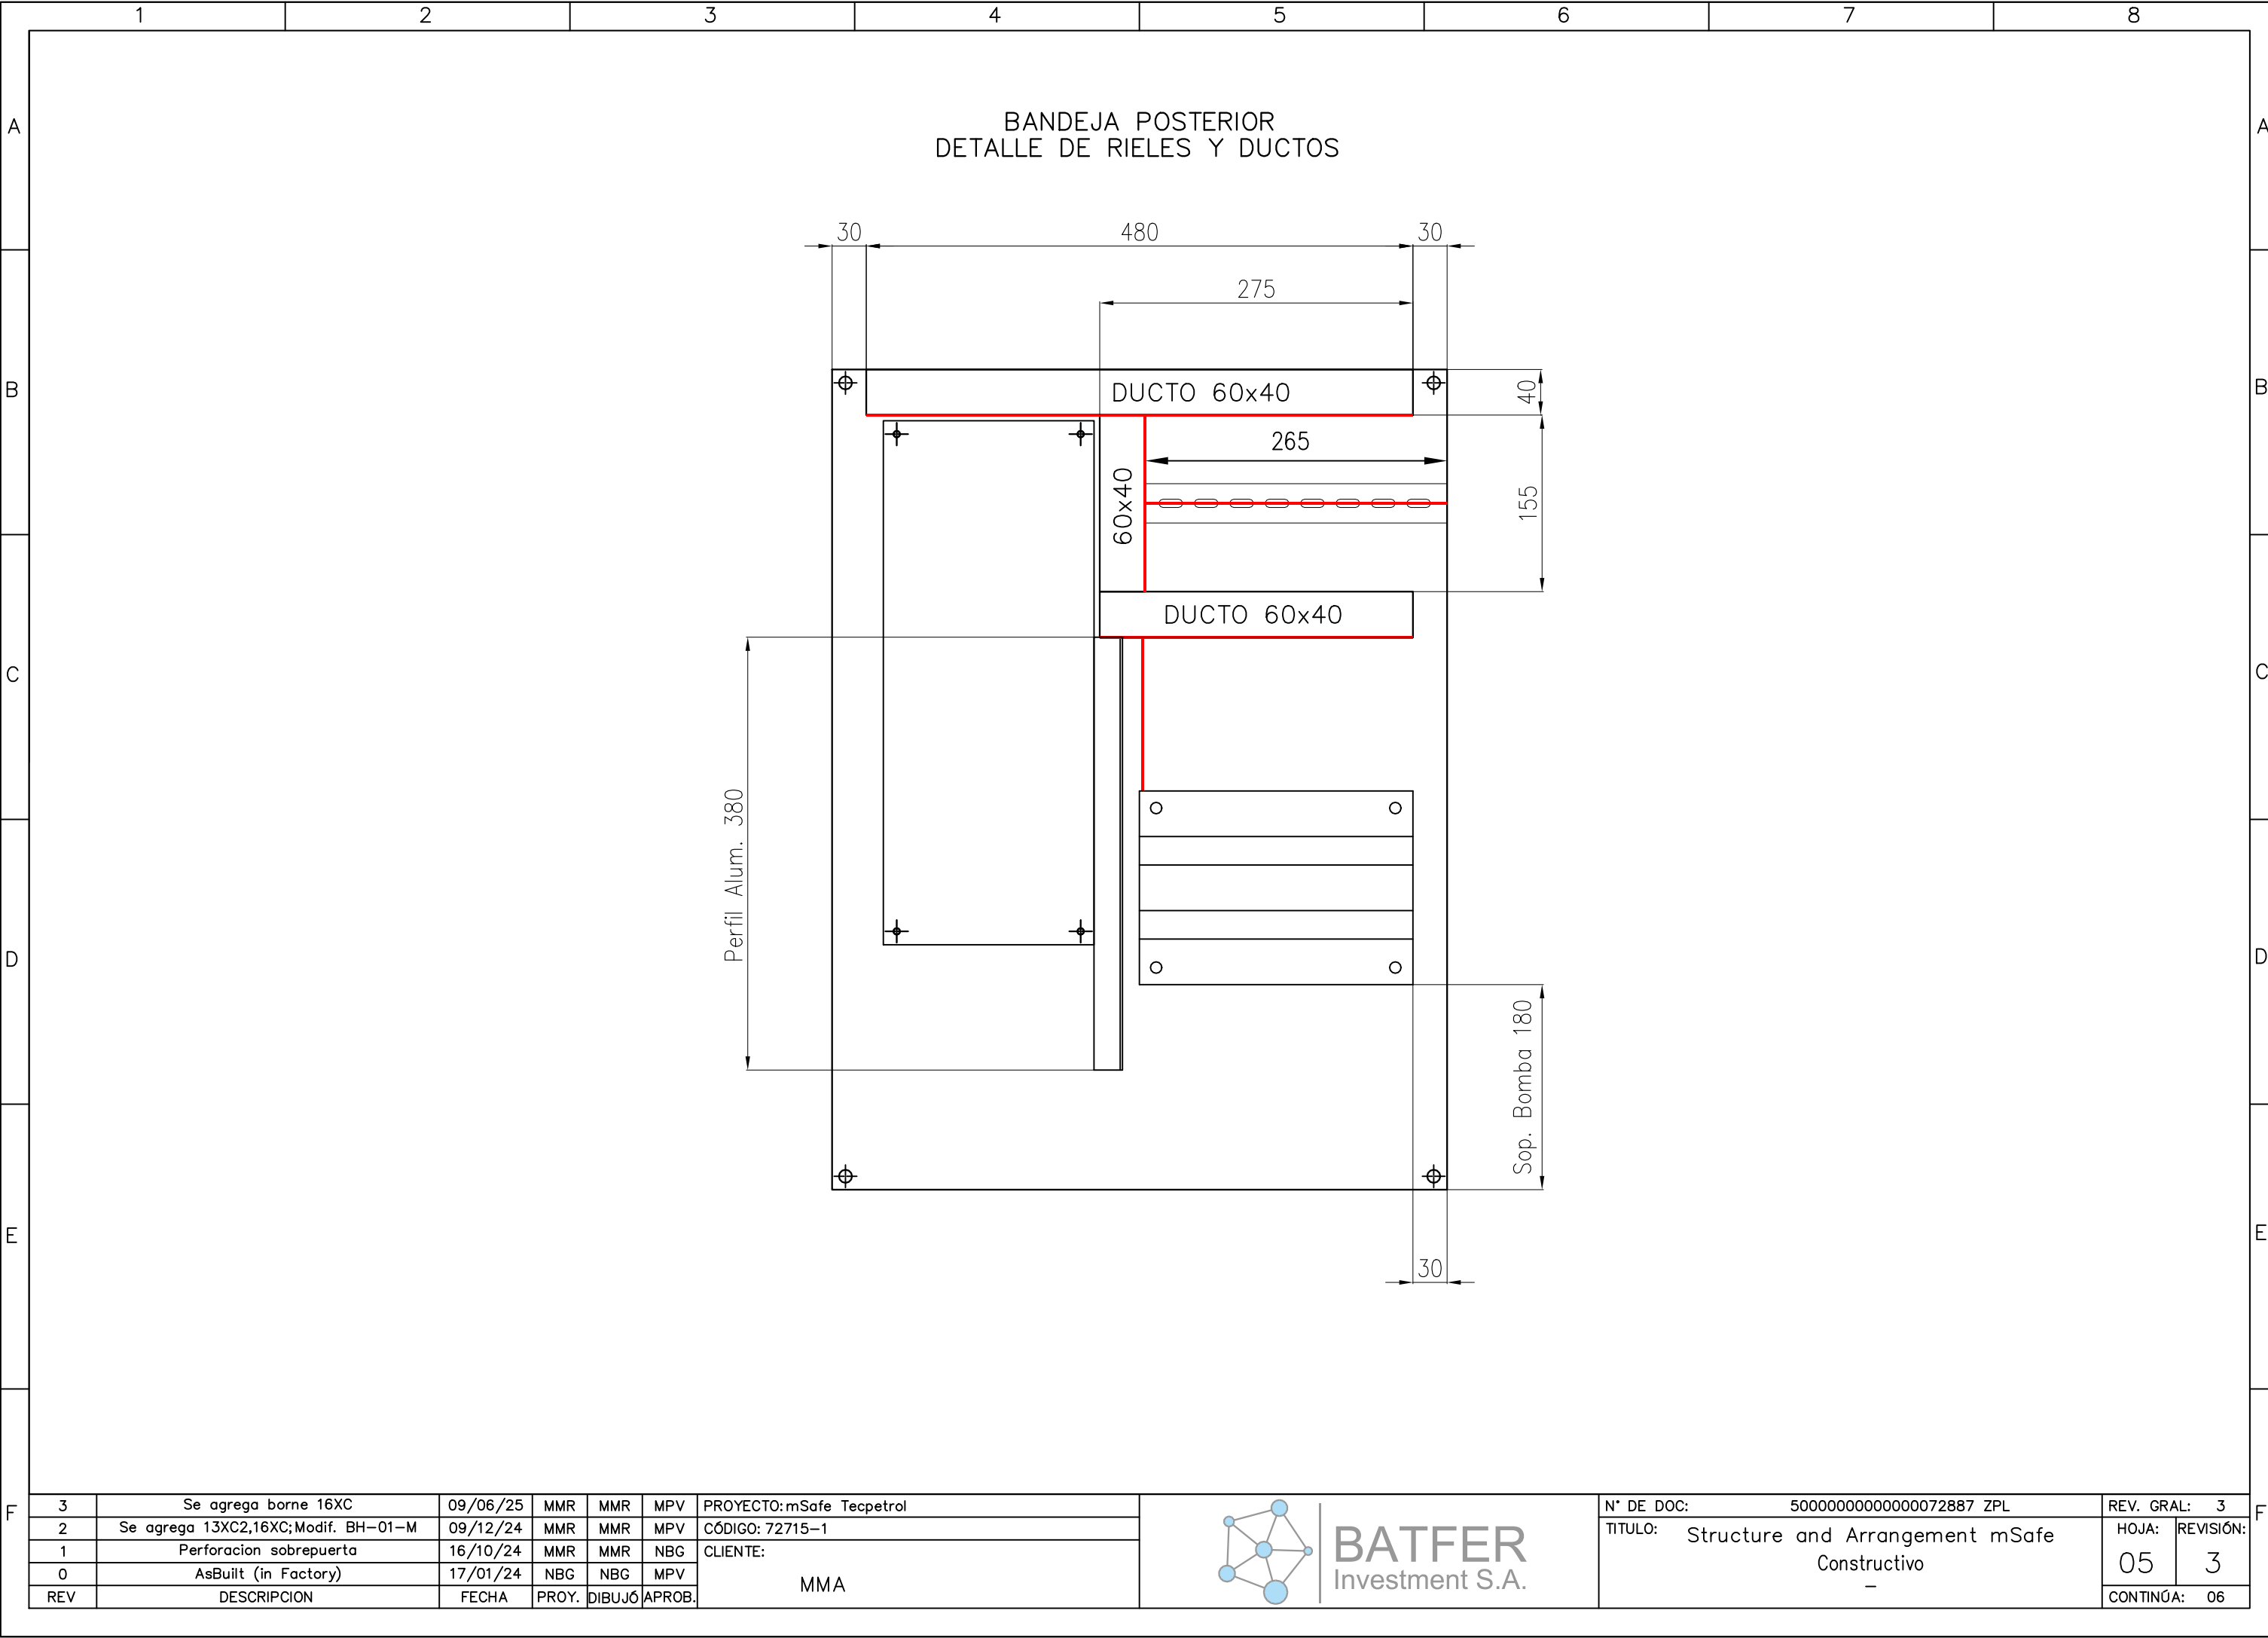

MMA S.A. OWNERSHIP OF THIS DOCUMENT IS RESERVED. IT IS PROHIBITED TO REPRODUCE, MODIFY OR TRANSFER WITHOUT PRIOR WRITTEN AUTHORIZATION.

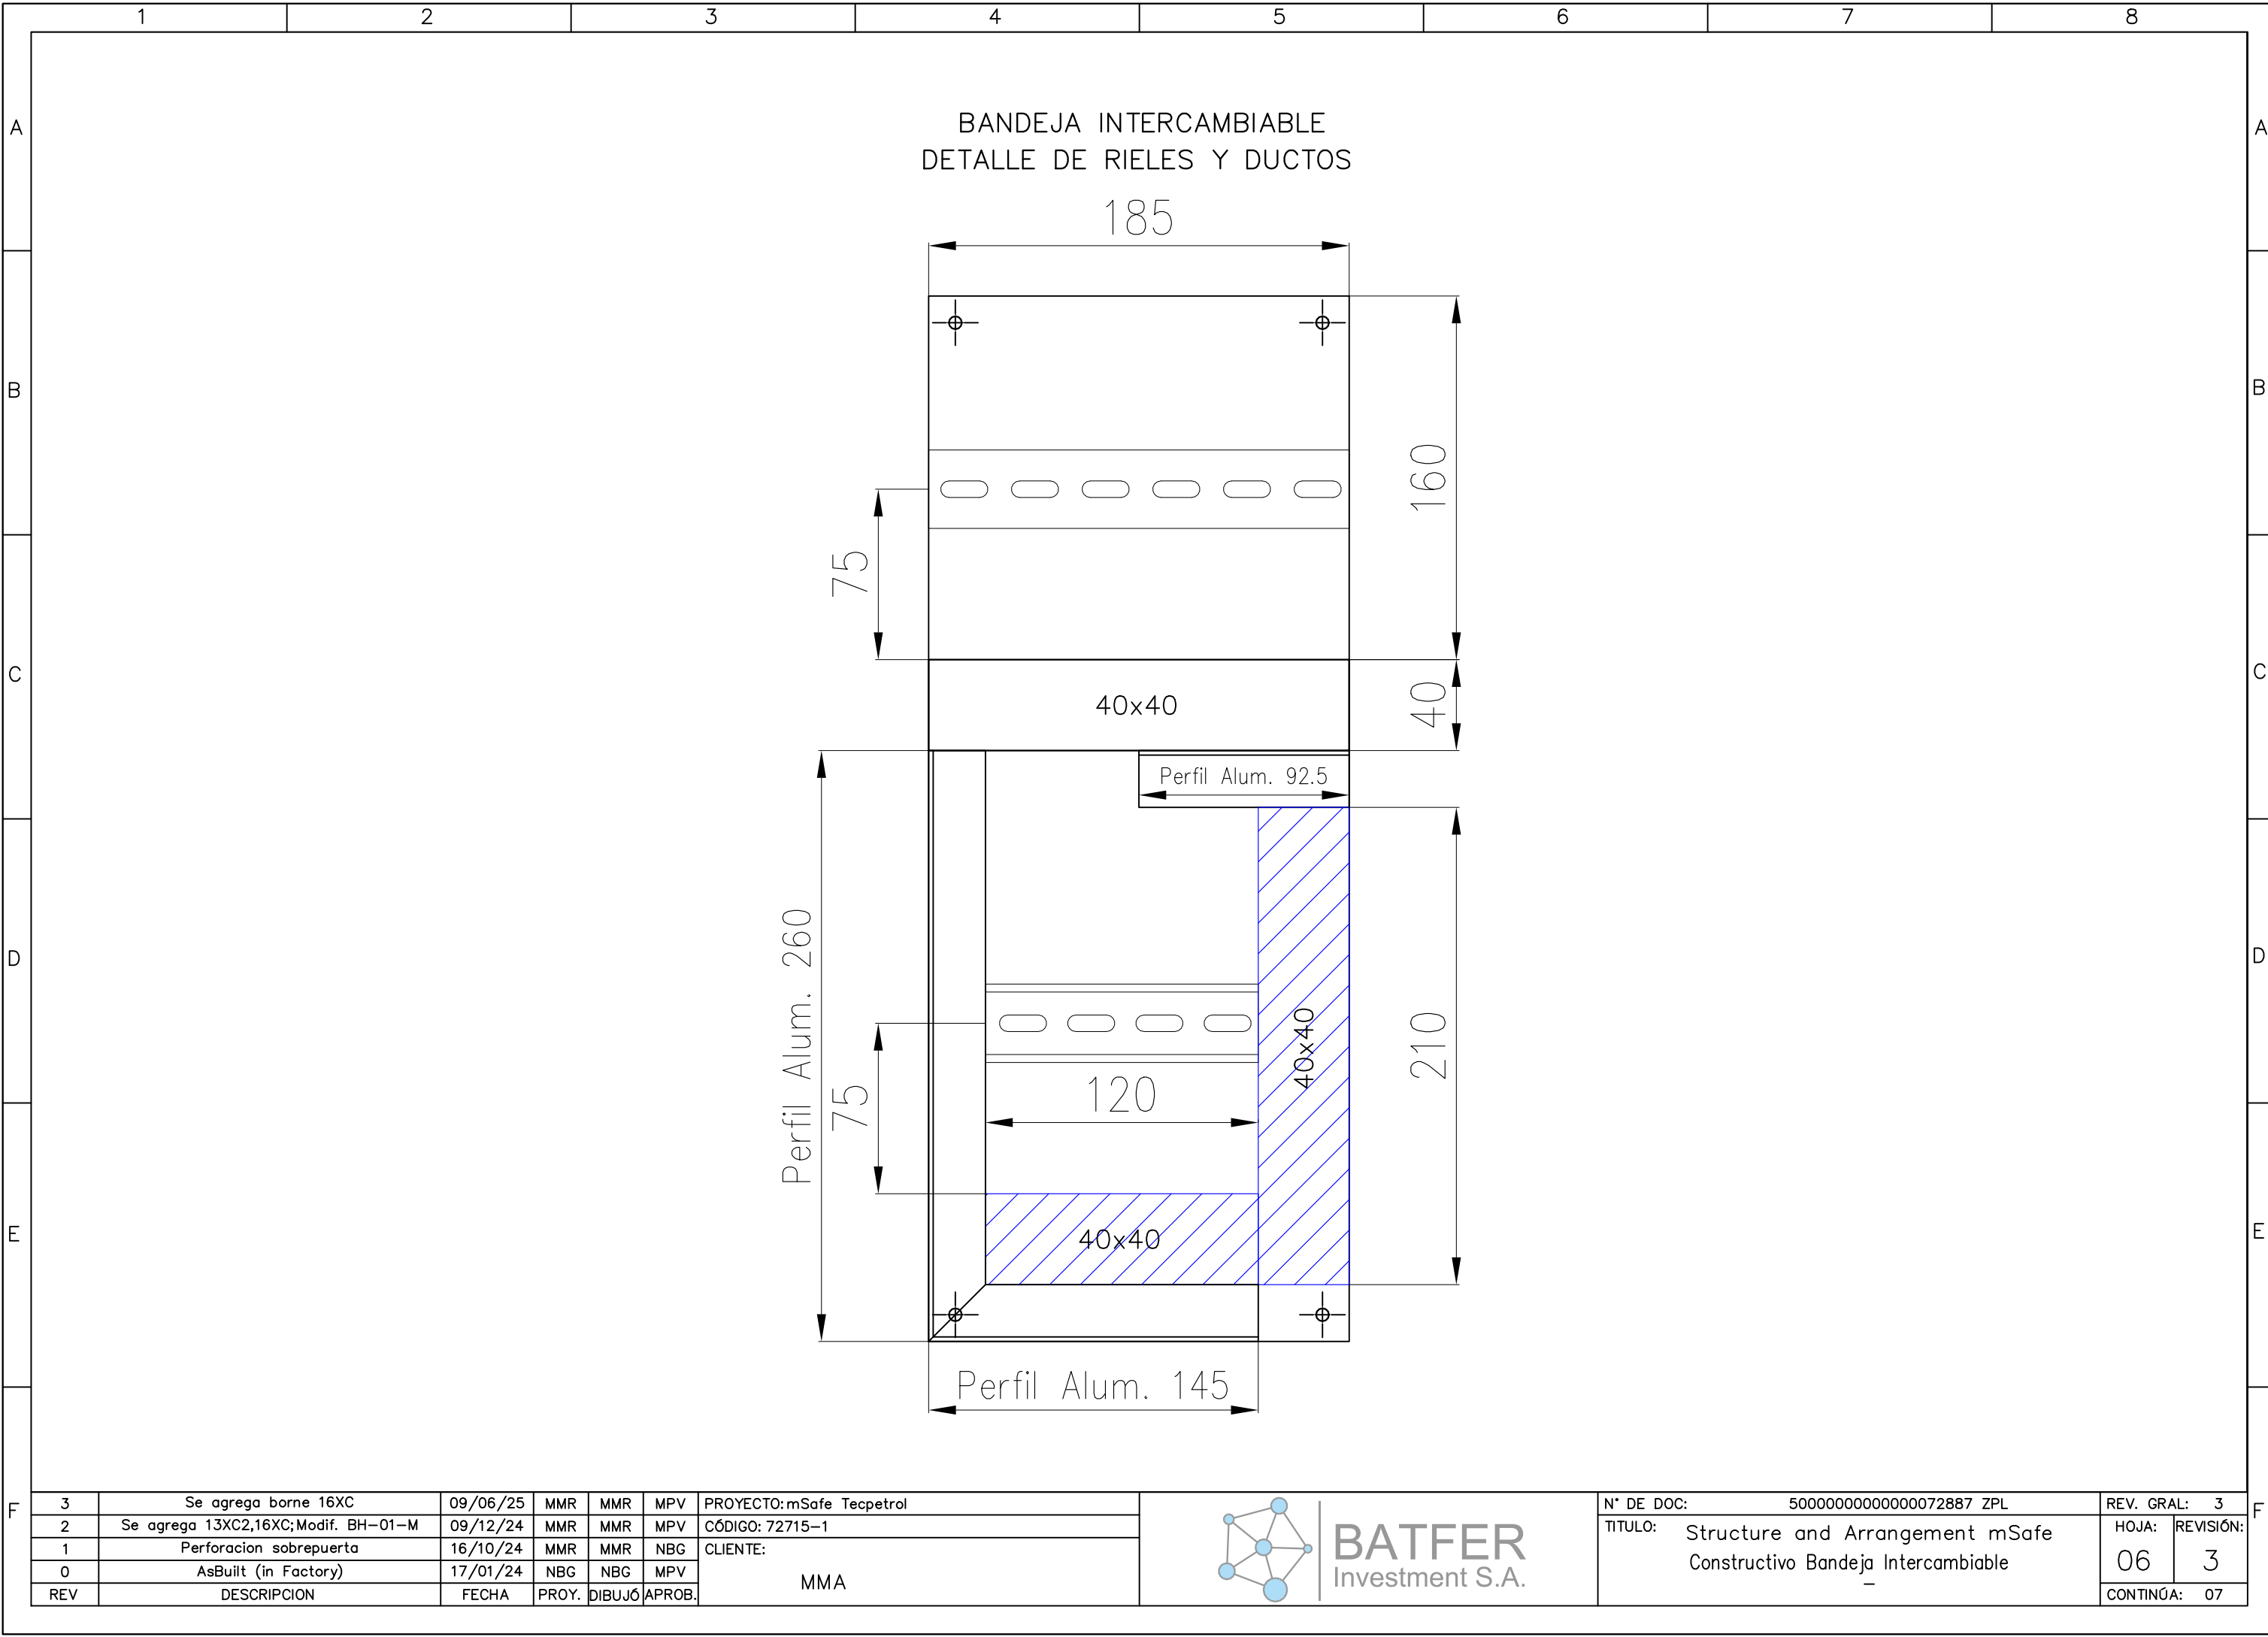


3	Se agrega borne 16XC	09/06/25	MMR	MMR	MPV	PROYECTO:mSafe Tecpetrol	MMA
2	Se agrega 13XC2,16XC;Modif. BH-01-M	09/12/24	MMR	MMR	MPV	CÓDIGO: 72715-1	
1	Perforacion sobrepuerta	16/10/24	MMR	MMR	NBG	CLIENTE:	
0	AsBuilt (in Factory)	17/01/24	NBG	NBG	MPV		
REV	DESCRIPCION	FECHA	PROY.	DIBUJÓ	APROB.		




BATFER
Investment S.A.



N° DE DOC:	50000000000000072887 ZPL		REV. GRAL:	3
TITULO:	Structure and Arrangement mSafe Constructivo Bandeja Intercambiable		HOJA:	06
			REVISIÓN:	3
			CONTINÚA:	07

MMA S.A. OWNERSHIP OF THIS DOCUMENT IS RESERVED. IT IS PROHIBITED TO REPRODUCE, MODIFY OR TRANSFER WITHOUT PRIOR WRITTEN AUTHORIZATION.

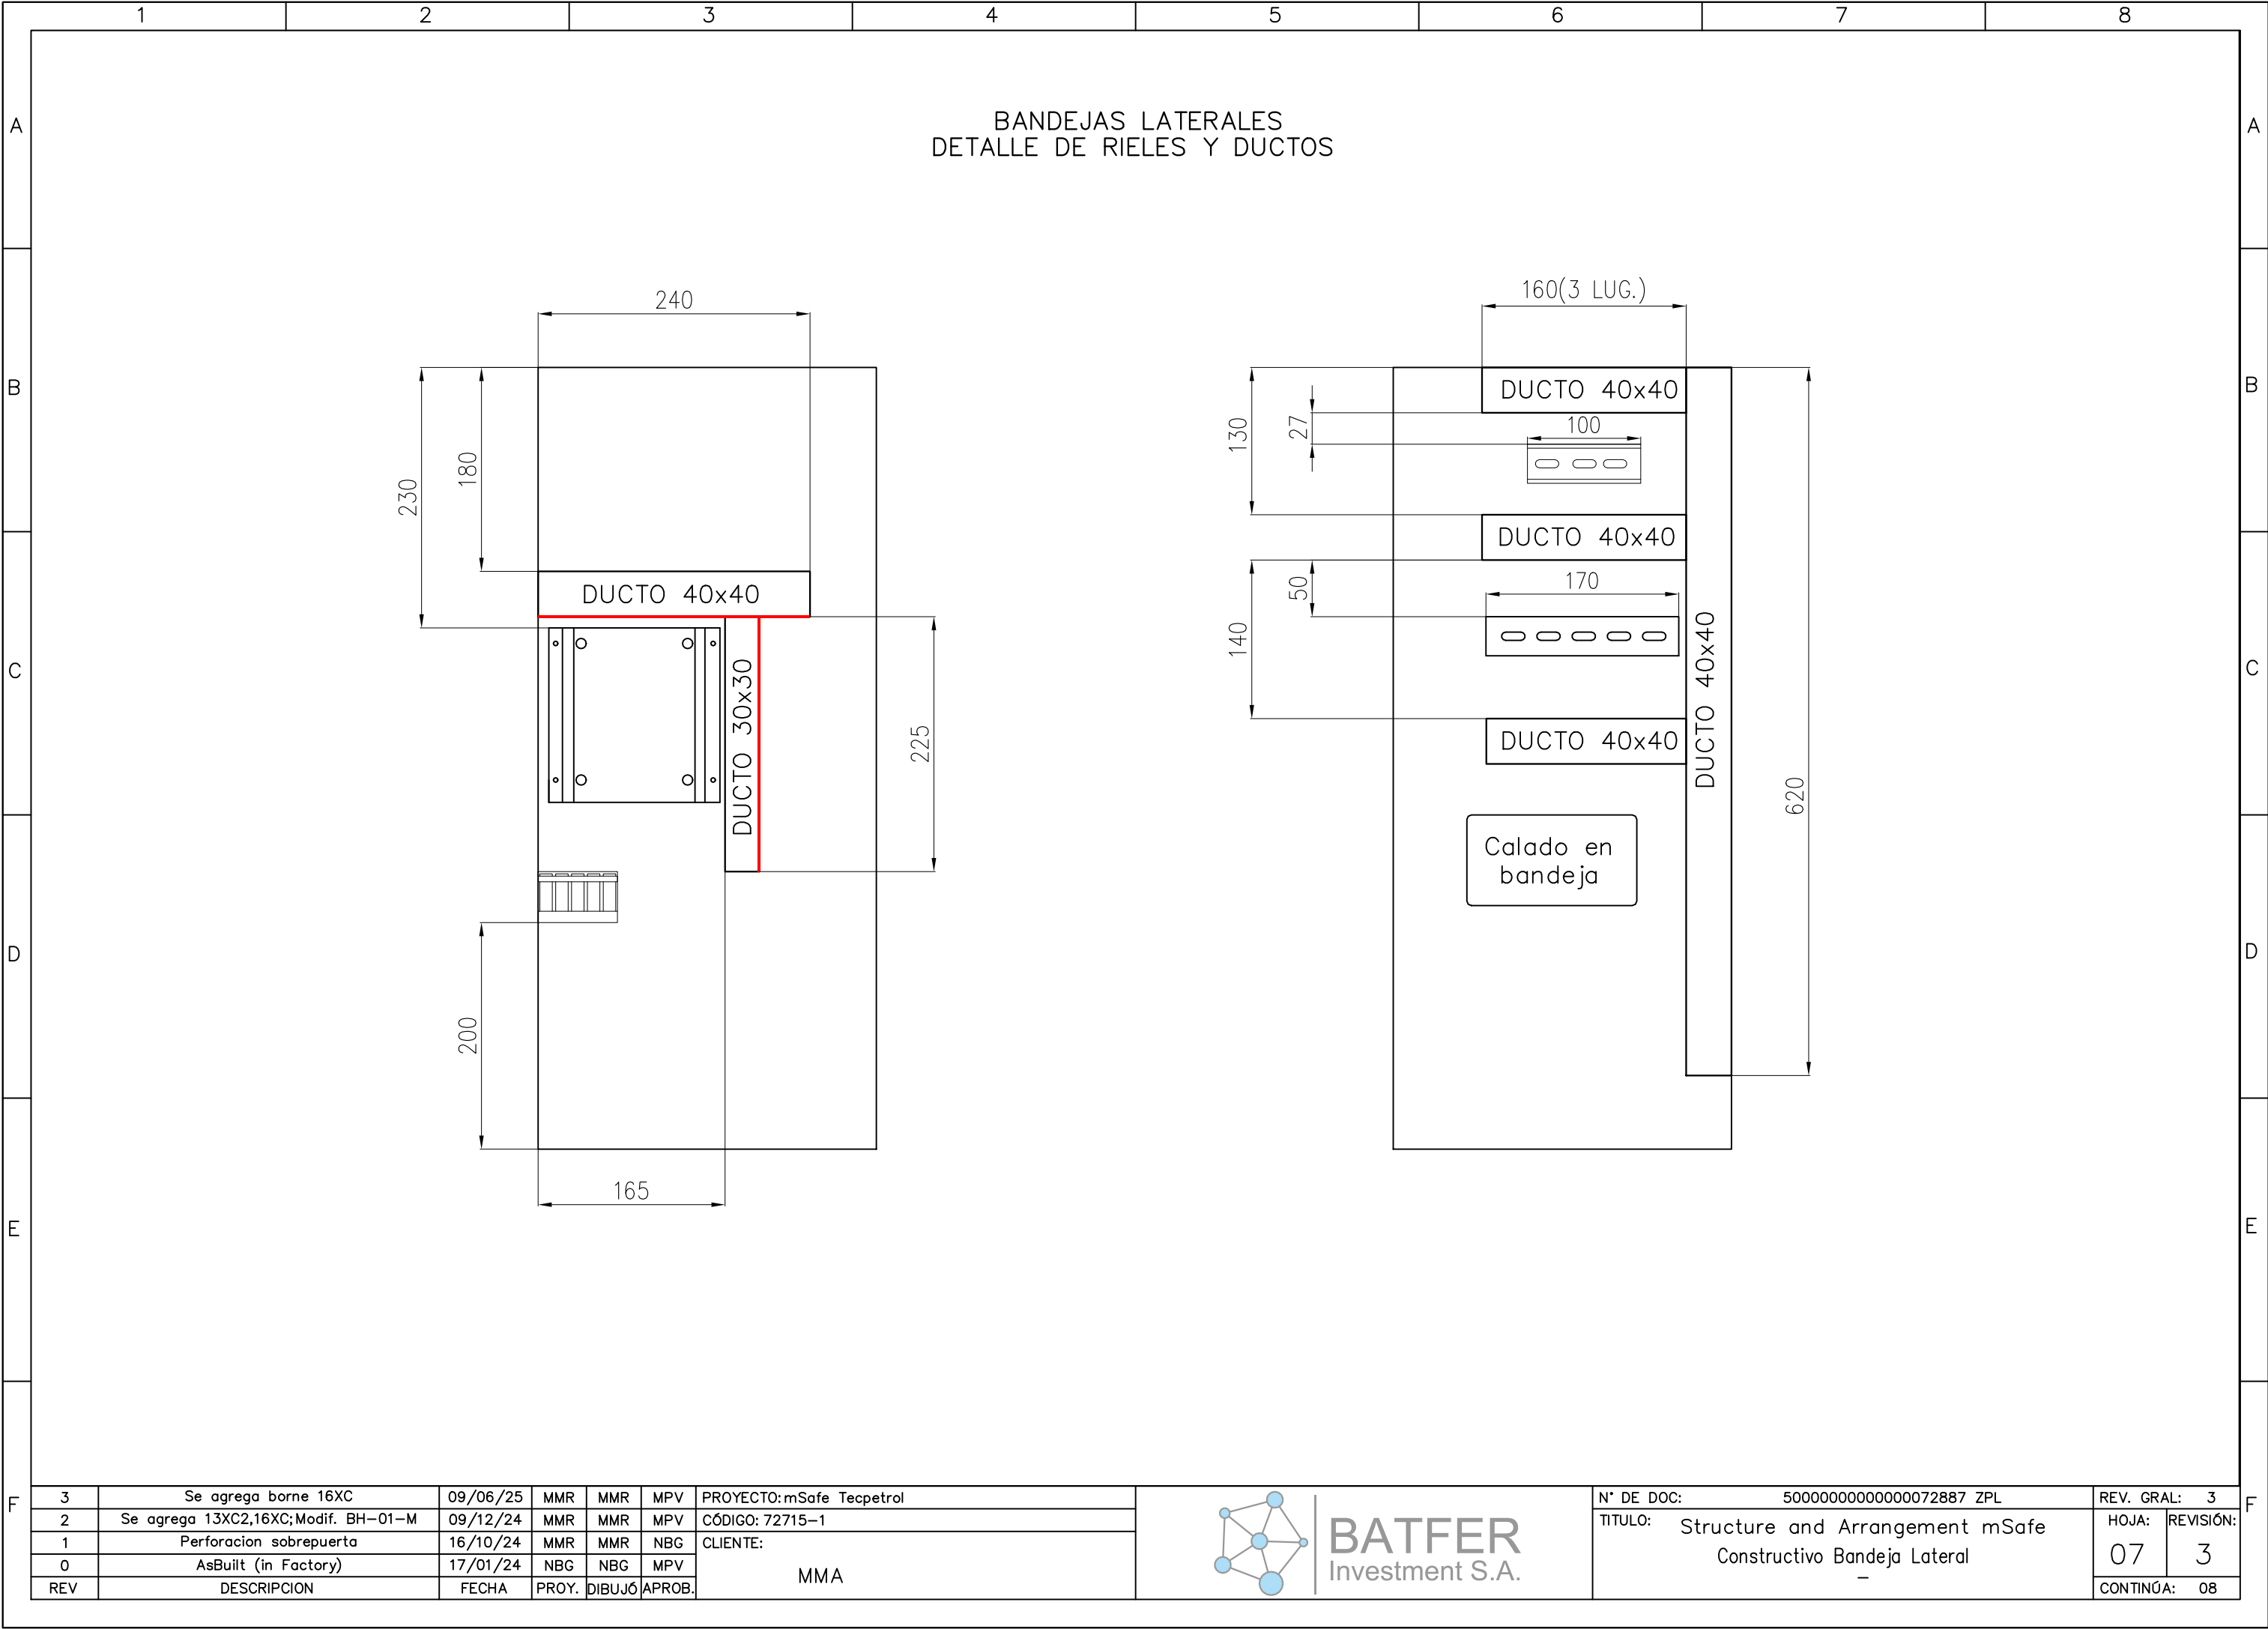


MMA S.A. OWNERSHIP OF THIS DOCUMENT IS RESERVED. IT IS PROHIBITED TO REPRODUCE, MODIFY OR TRANSFER WITHOUT PRIOR WRITTEN AUTHORIZATION.

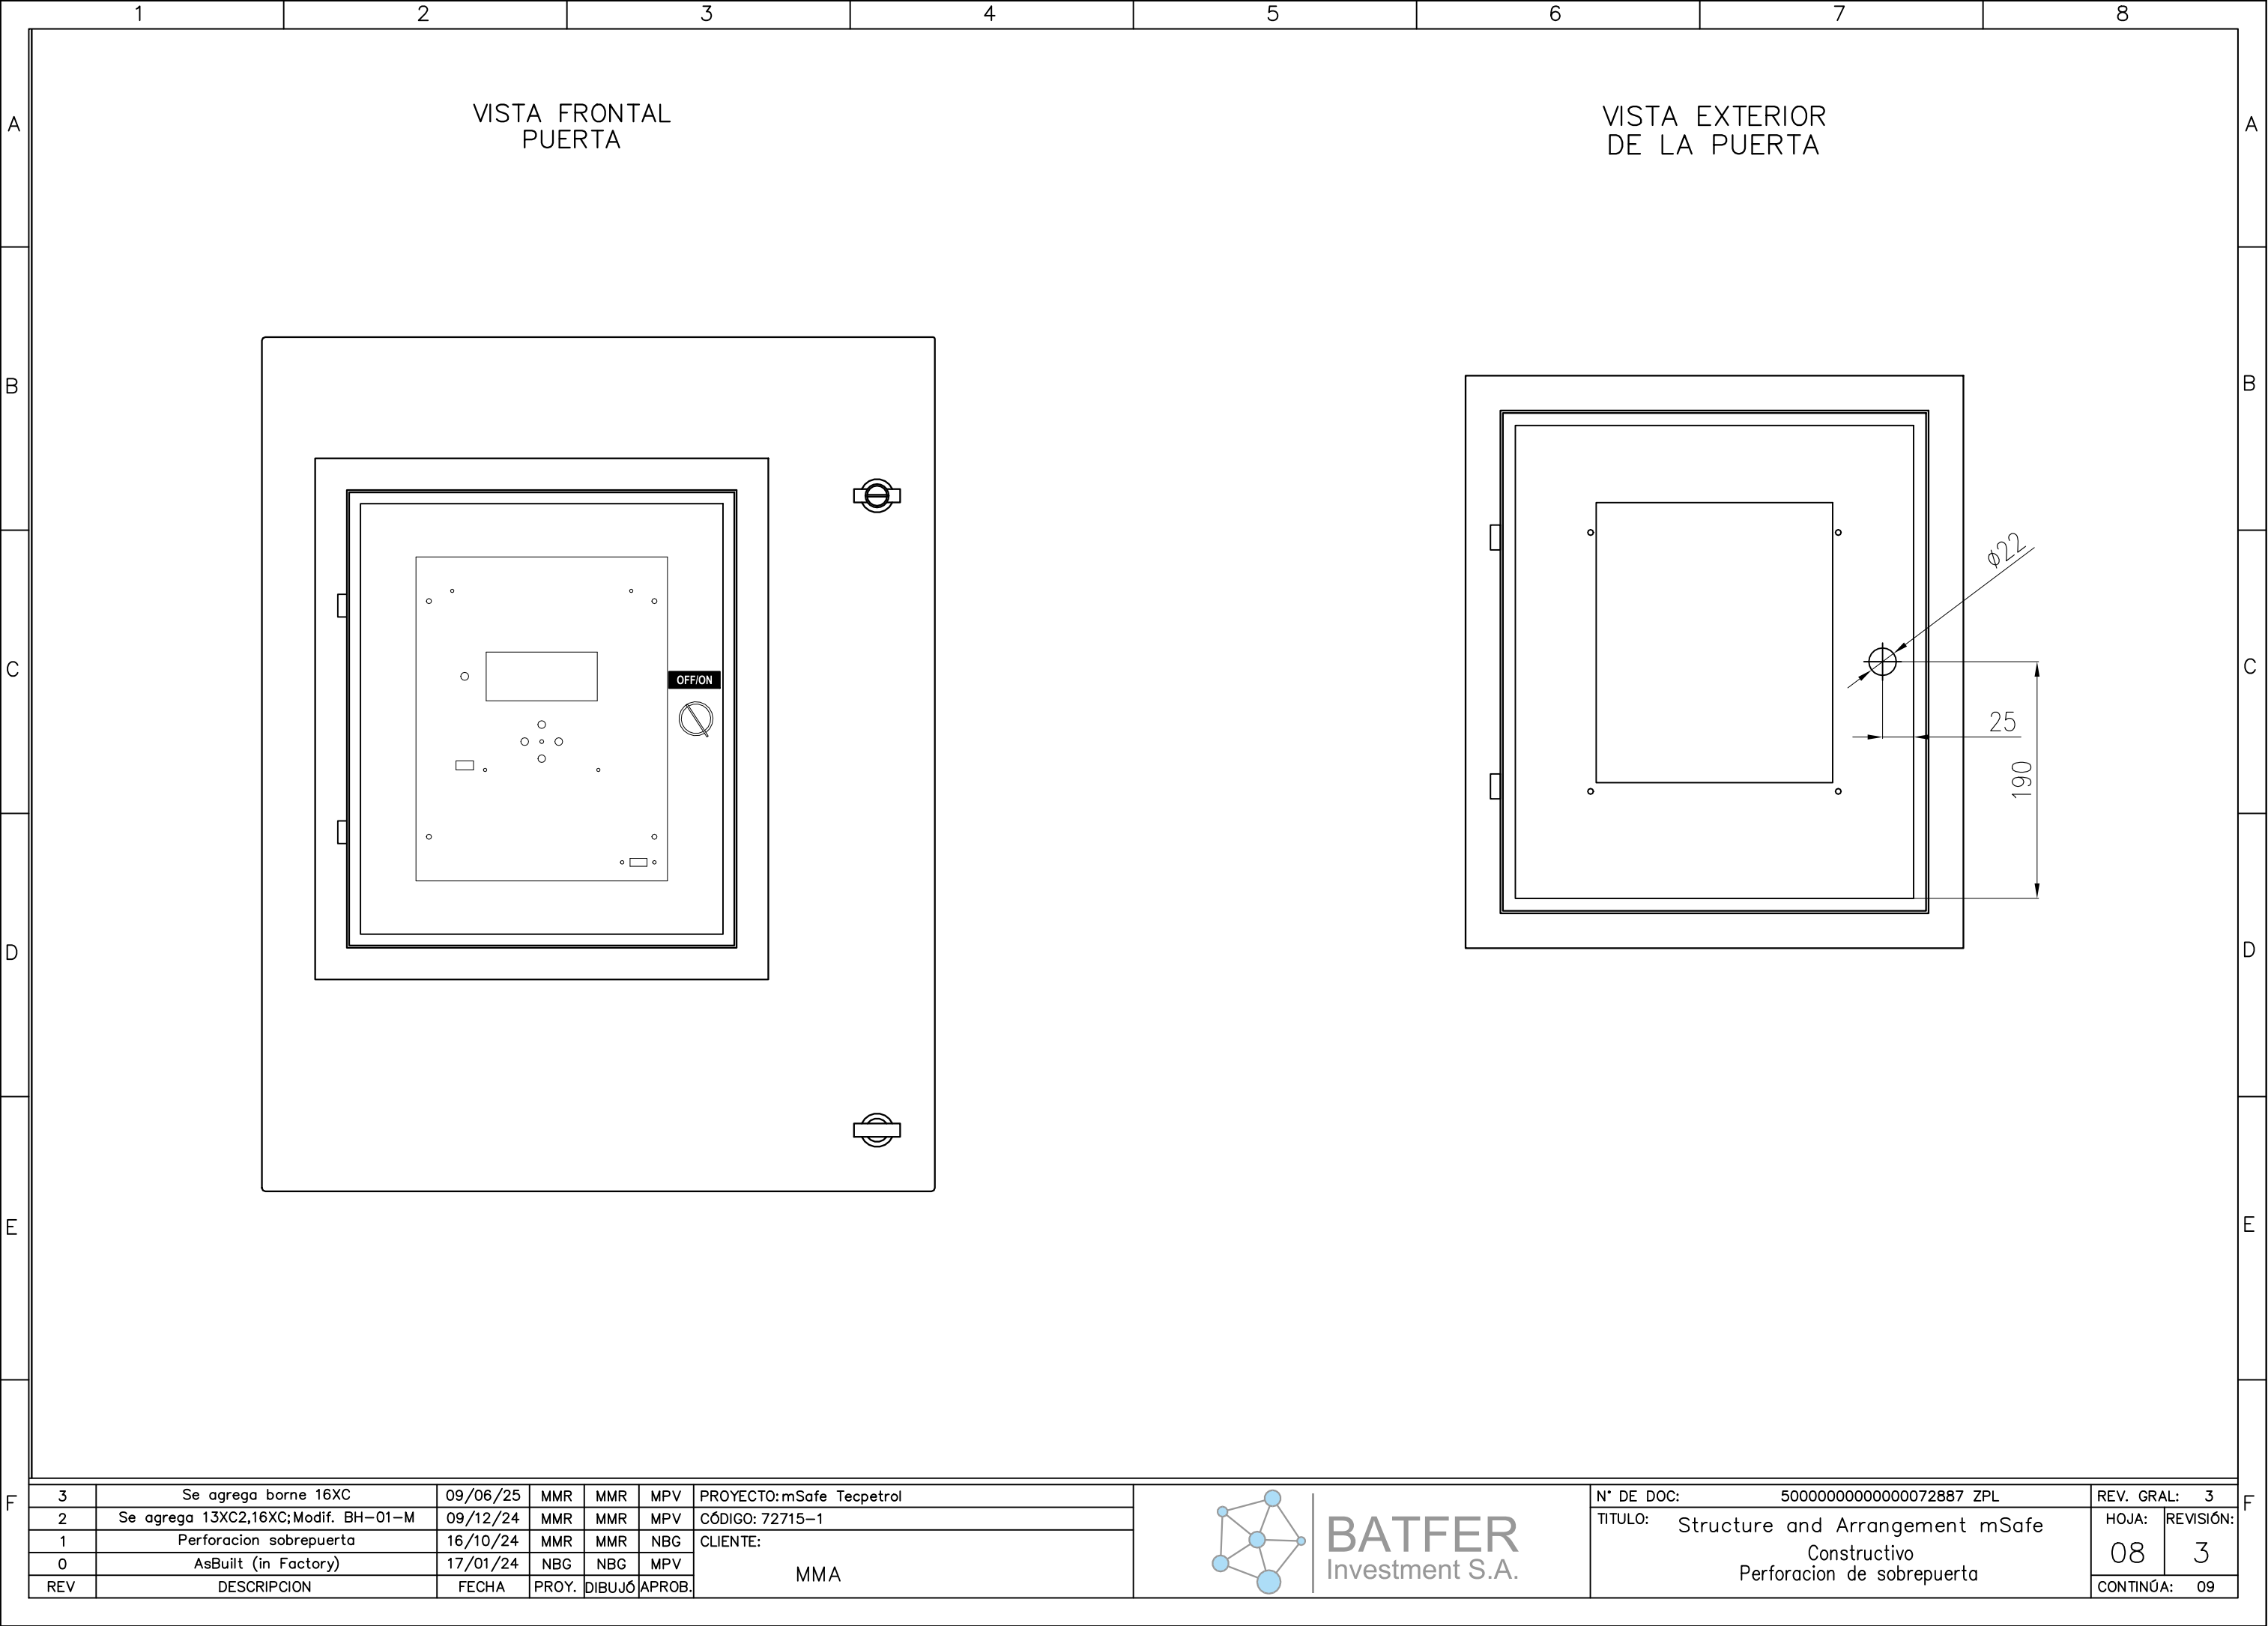

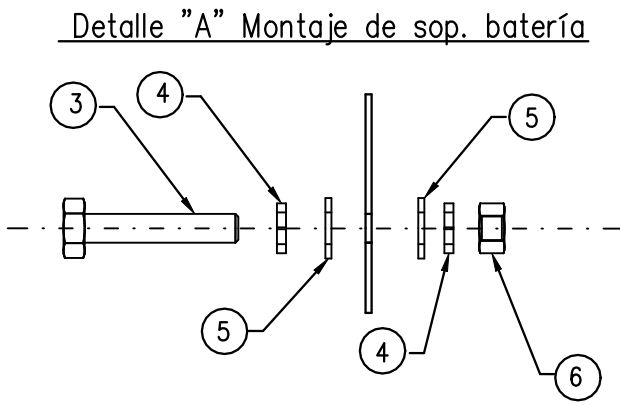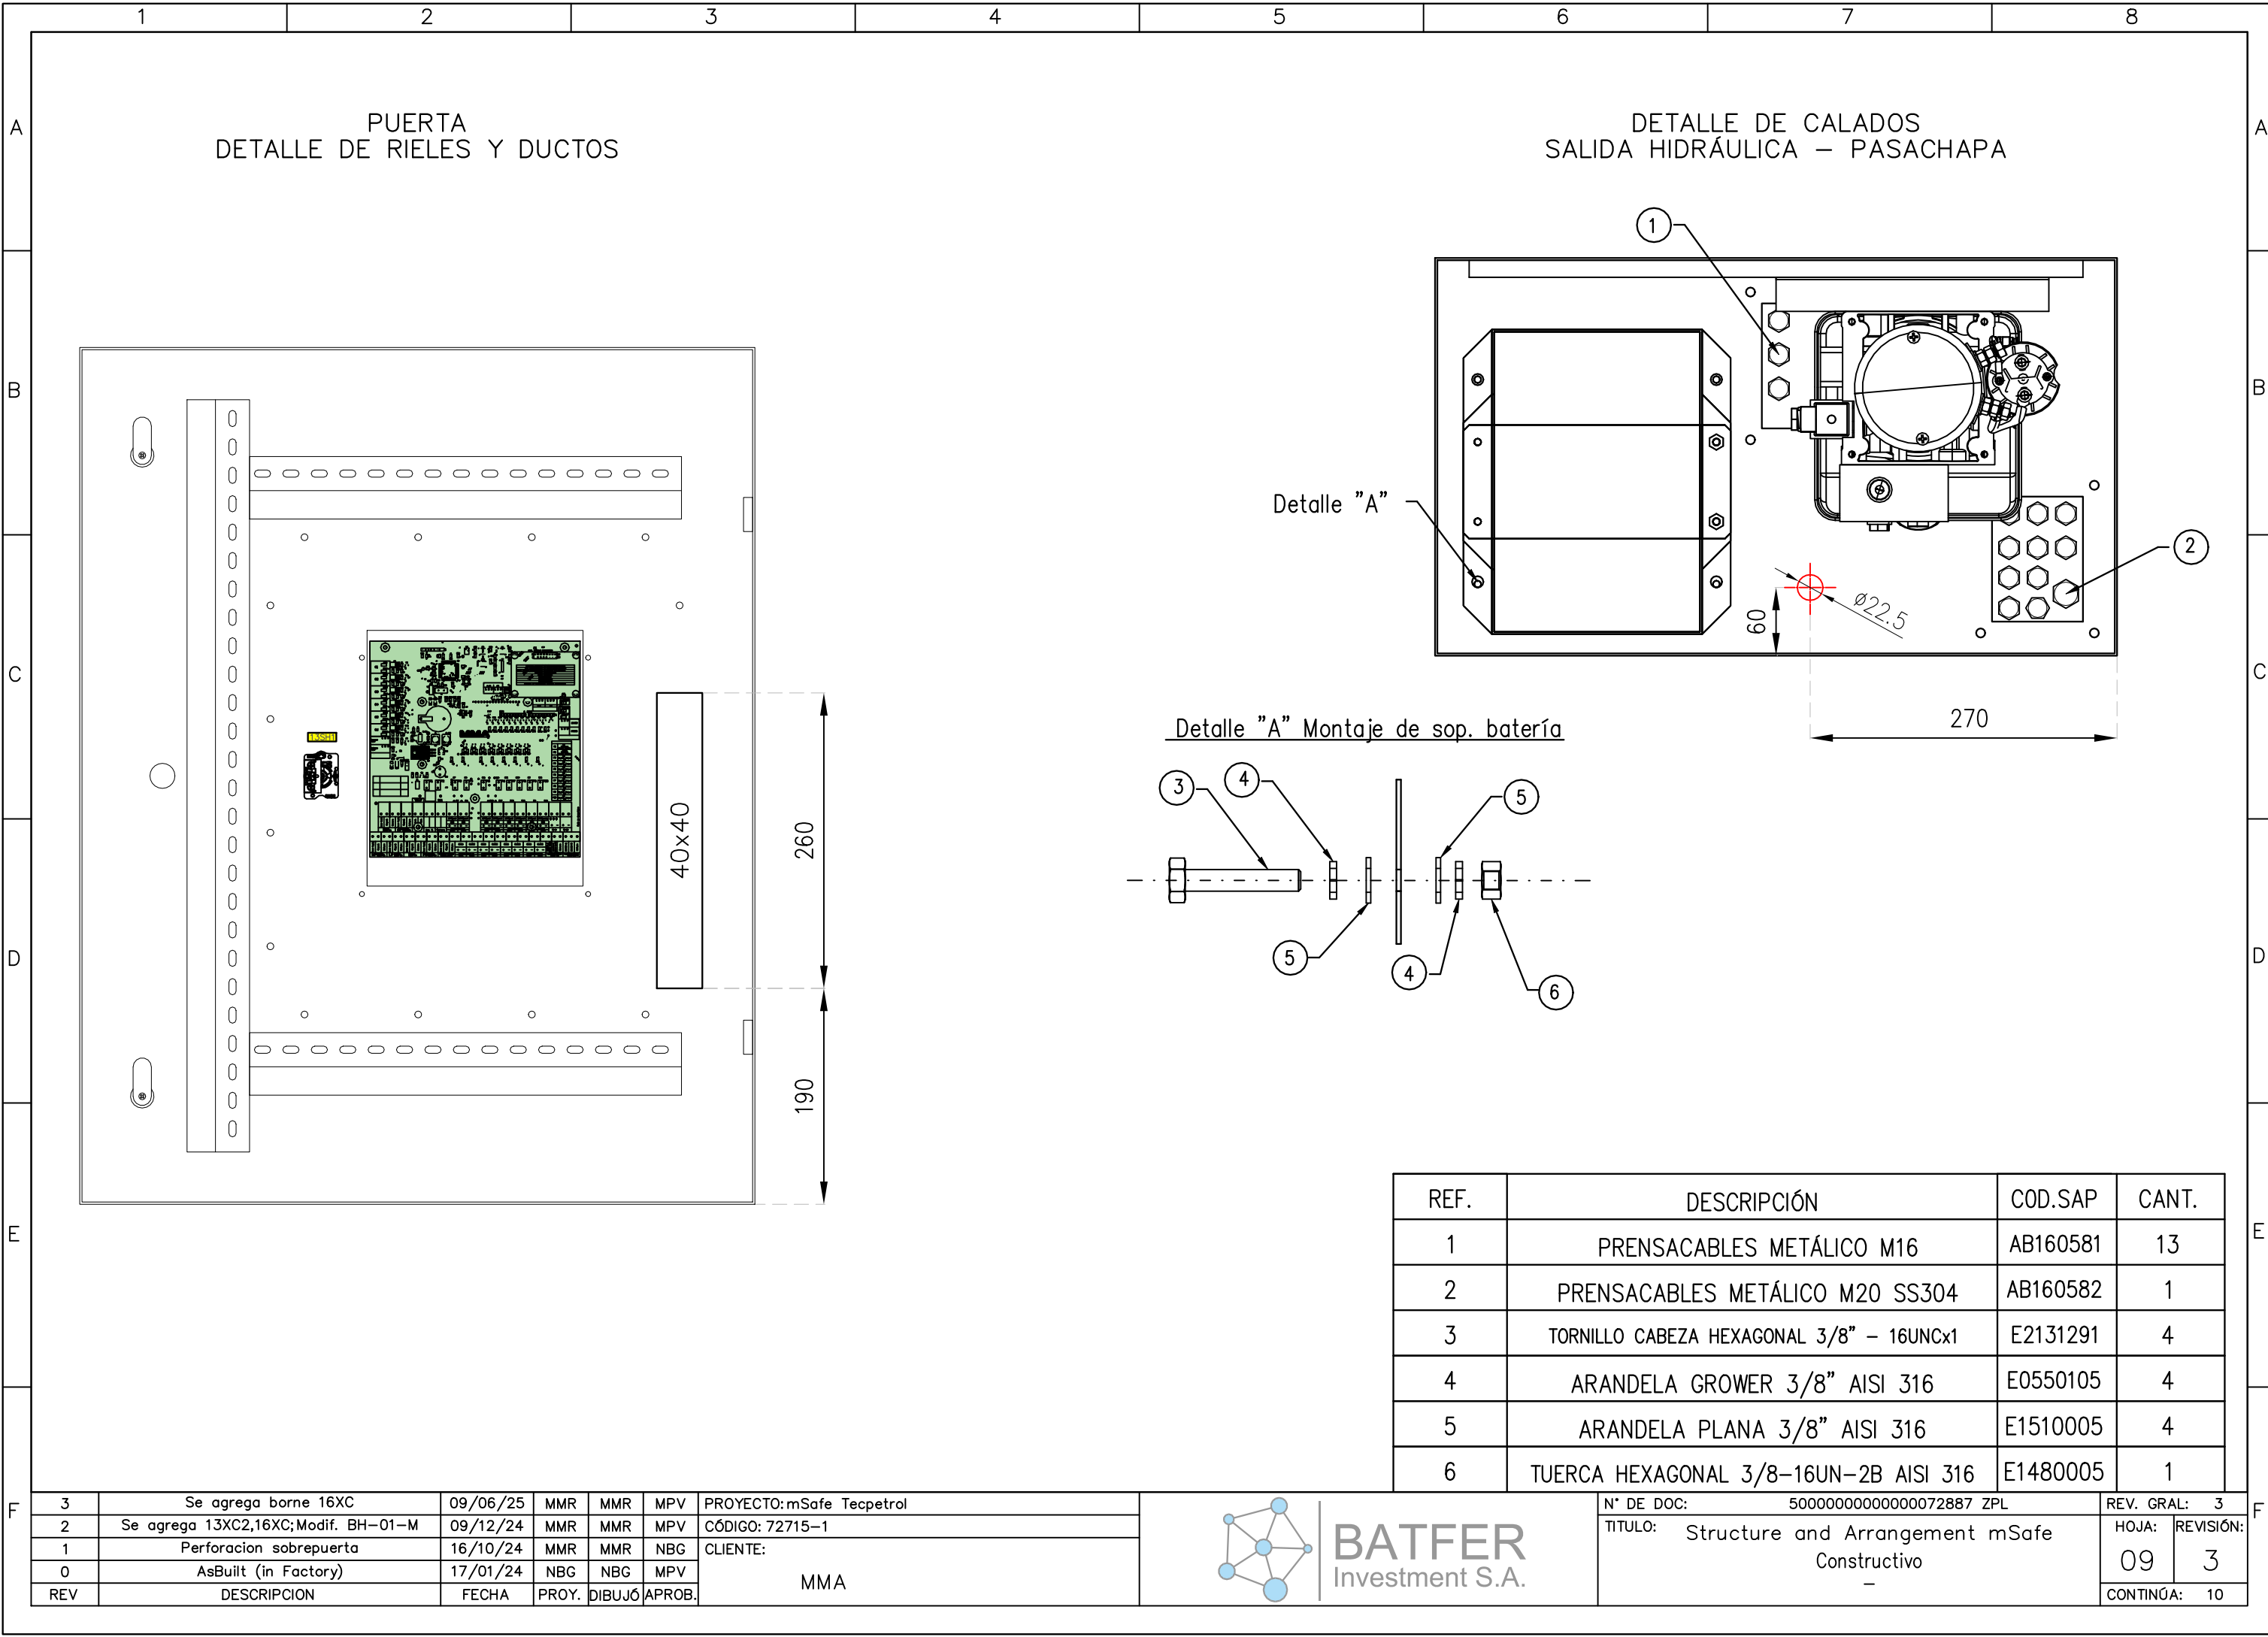

REF.	DESCRIPCIÓN	COD.SAP	CANT.
1	PRENSACABLES METÁLICO M16	AB160581	13
2	PRENSACABLES METÁLICO M20 SS304	AB160582	1
3	TORNILLO CABEZA HEXAGONAL 3/8" - 16UNCx1	E2131291	4
4	ARANDELA GROWER 3/8" AISI 316	E0550105	4
5	ARANDELA PLANA 3/8" AISI 316	E1510005	4
6	TUERCA HEXAGONAL 3/8-16UN-2B AISI 316	E1480005	1

3	Se agrega borne 16XC	09/06/25	MMR	MMR	MPV	PROYECTO:mSafe Tecpetrol
2	Se agrega 13XC2,16XC;Modif. BH-01-M	09/12/24	MMR	MMR	MPV	CÓDIGO: 72715-1
1	Perforacion sobrepuerta	16/10/24	MMR	MMR	NBG	CLIENTE:
0	AsBuilt (in Factory)	17/01/24	NBG	NBG	MPV	MMA
REV	DESCRIPCION	FECHA	PROY.	DIBUJÓ	APROB.	

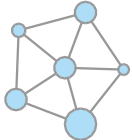

BATFER
Investment S.A.

N° DE DOC:	50000000000000072887 ZPL	REV. GRAL:	3
TITULO:	Structure and Arrangement mSafe Constructivo	HOJA:	09
		REVISIÓN:	3
		CONTINÚA:	10

